

CERTIFIED LAND CORNER RESTORATION



Index No. X-12

State of Wisconsin

County of Oneida } ss.

I, Phillip T. Hansen, do hereby certify that on the 6th day of September, 1978, I ~~restored~~ established the EC 1/16 corner of Section 33, Township 35, North, Range 11 East, Fourth Principal Meridian, as described hereon; and that from this evidence I established a new monument and accessories as described hereon to perpetuate the original location of this corner.

Resident witnesses: Glen Barker, Jim Clafin, Herb Wagoner

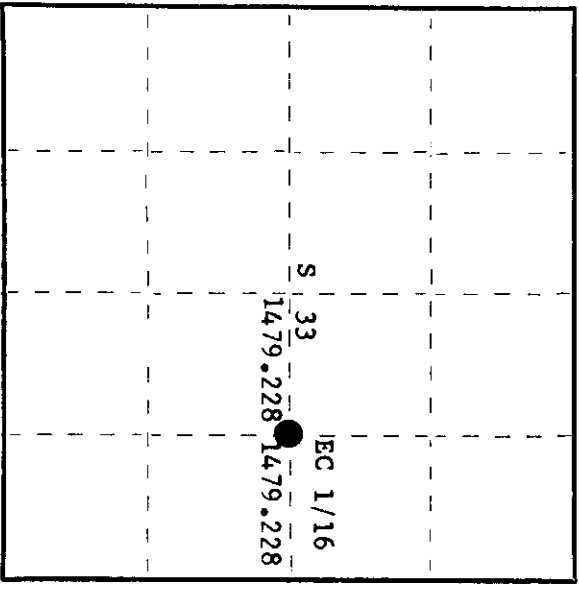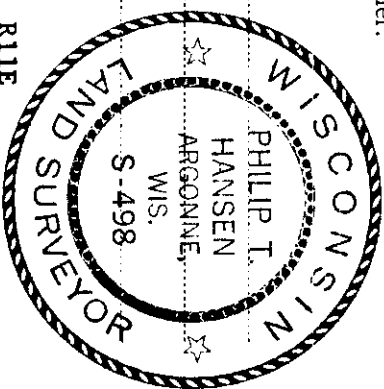

History of original corner establishment: No records of any previous survey.

Description of corner evidence found:

No evidence of any corner recovered. Corner established by traverse and computation. Established C 1/4 corner from traverse and computation of E-W and N-S 1/4 lines. C 1/4 corner is 2958.455 feet N 88° 32' 26" W of E 1/4 corner. Set EC 1/16 at 1479.228 feet intermediate.

Description of monument and accessories I established to perpetuate the original location of this corner.

Set 1 1/2" iron pipe with 2" brass cap for corner. Cap stamped: Monument projects 24" above ground. Marked NBT's - cedar 12" N34°W, 8.97 feet maple 8" N40°E, 30.15 feet, scribed 1/16 BT. S498 T35N R11E EC 1/16 S 33 CPI-1978

Dated at Rhinelander, Wis., this 11th day of September, 1978

Signature: Phillip T. Hansen, Title: Registered Land Surveyor, Registration No. S-498

Office of Register of Deeds, County of Oneida. Instrument was filed in this office for record on the 25th day of September, 1978 at 2:50 o'clock P.M.

Signature: Doree Leauge Fuchs, (Register of Deeds)

By: Deputy

3511332010