

CERTIFIED LAND CORNER RESTORATION

Index No. **X-11**

State of Wisconsin

County of Oneida } ss.

I Phillip T. Hansen, do hereby certify that on the 6th day of September, 1978, I ~~restored~~ re-established the C 1/4 corner of Section 33 Township 35 North, Range 11 East, Fourth Principal Meridian,



as described hereon; and that from this evidence I established a new monument and accessories as described hereon to perpetuate the original location of this corner.

Resident witnesses:

Glen Barker

Jim Clafflin

Herb Wagoner

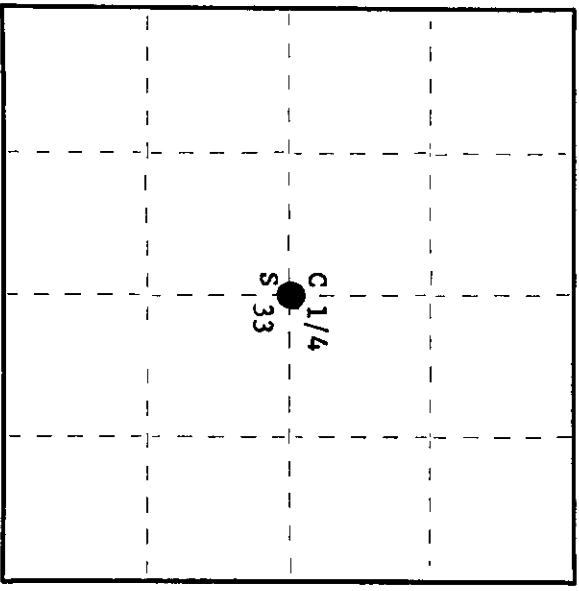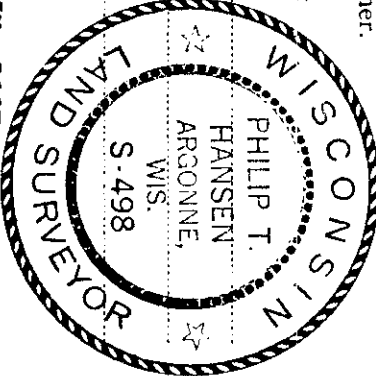

○ = Corner monument restored.

History of original corner establishment:

No records of any previous survey. D.H. Vaughan ran the N-S 1/4 line in 1901, but no mention was made of any C 1/4 being established.

Description of corner evidence found:

No evidence of any corner recovered. Corner established by traverse and computation. Corner sets 2474.738', S 1° 11' 01" E of N 1/4 corner, 2958.455' N 88° 32' 26" W of E 1/4 corner, 2676.796 N 1° 11' 01" W of S 1/4 and 2601.339' S 88° 32' 26" E of W 1/4 corner.

Description of monument and accessories I established to perpetuate the original location of this corner.

Set 2 1/2" Berntsen A-1 Federal Monument (CPI) 2958.455' N 88° 32' 26" W of E 1/4 corner and 2676.796' N 1° 11' 01" W of S 1/4. Cap stamped:

Monument projects 24" above ground.
Marked NBT's - Sugar 6" N39°E, 15.80'
Sugar 6" S82°W, 5.80'
Sugar 6" S48°E, 30.22'
all scribed C 1/4 BT
T35N R11E
C 1/4 S 33
S498-1978

Dated at Rhineland, Wis., this 11th day of September, 1978.

Signature Phillip T. Hansen Title Registered Land Surveyor Registration No. S-498
(County Surveyor, Registered Land Surveyor, or other duly authorized official)

Office of Register of Deeds, County of Oneida
Instrument was filed in this office for record on the 25th day of September, 1978
at 5:00 o'clock P. M.

Signature Doris George Fisher
(Register Deeds)

By _____ Deputy