U.S. PUBLIC LAND SURVEY MONUMENT RECORD

Note: This form is intended and designed to fulfill all requirements of Wisconsin Administrative Code, Chapter A-E 7.08 U.S. Public Land Survey Monument Record (3) (a) (b) (c) (d) (e) (f) (g) (h) (i). An additional sheet may be added if necessary to conform with said requirements.

(a) Corner location: Township 35 North

Range 11 East/West

Town/City/Village SCHOEPKE

County ONEIDA

REGISTER OF DEEDS OFFICE
ONEIDA COUNTY WIS
SEP 0 1991
At ____ O'Clock ____ M
THOMAS H. LEIGHTON
REGISTER OF DEEDS

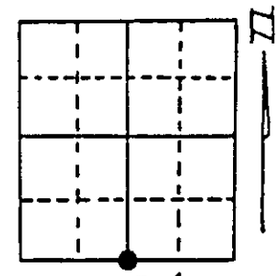

Section 34

(b) (f) (g) (h) Description of monument found at this corner and if it was accepted, state all evidence (material, testimonial, occupational, plats, records, other monuments) used as a basis for accepting. If not accepted or if nothing was found, state evidence used as basis for establishing location. If reestablished through lost corner proportionate methods, indicate all monuments, distances and directions used to establish. Indicate type of monument found or set and sign post.

1859 — H.C. FELLOWS ESTABLISHED ORIGINAL CORNER

1967 - ROBERT J. POSS FOUND SQD. STAKE — 5" SQ. MKD. "S 3" ON SOUTH SIDE SEC. 34 ON NORTH & 1/4 COR ON WEST SIDE. 1 1/2" PIPE ALONG SIDE ON E. SIDE OF TOWN ROAD. SET 1" I.P. WITH BRASS CAP IN 6"x 42" CONCRETE ALONG SIDE.

1990 - I FOUND 4x4 SCRIBED WOOD, A 1 1/2" IRON PIPE ALONG SIDE & 1" BRASS CAP IN CONCRETE. & 3 EXISTING BT'S.

(c) (d) (e) Plan view of corner with ties to at least 4 witness monuments. If in disagreement with previously established corner, show the distances between the two corners and also indicate the ties to the disputed corner.

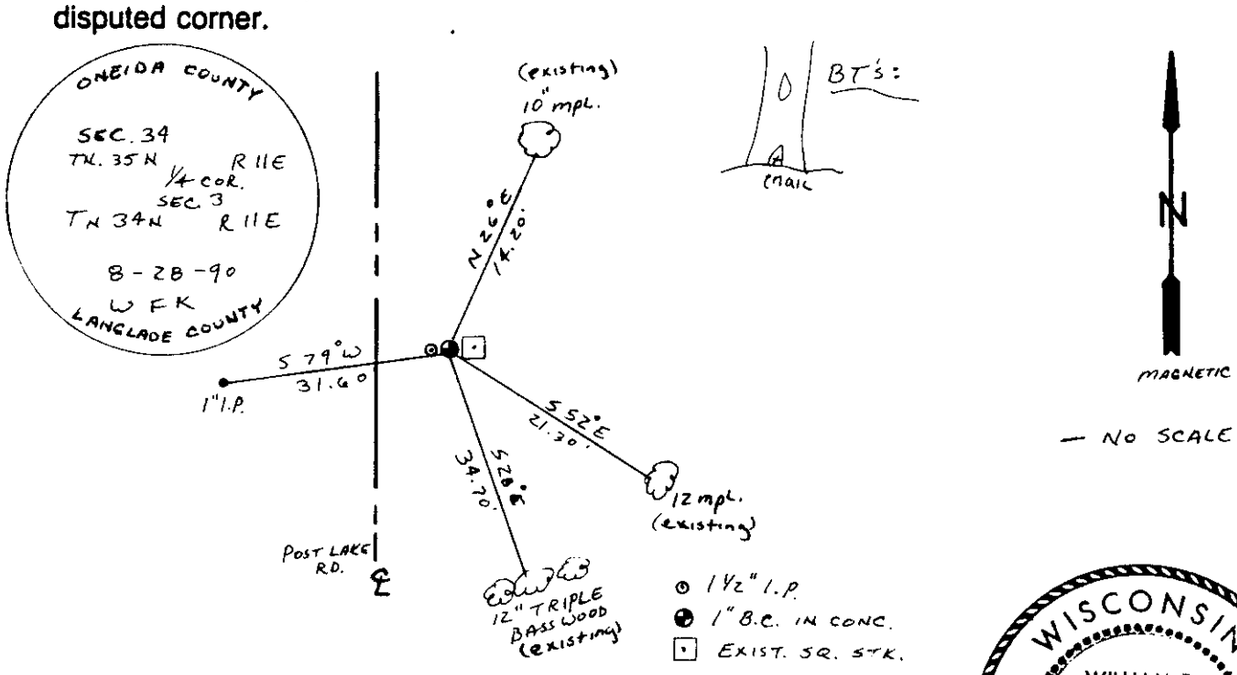

(i) I, WILLIAM F. KELLY (type or print name) certify that the corner location on this record was determined by me or under my direction and control and that this U.S. Public Land Survey Monument Record is correct and complete to the best of my knowledge and belief.

William F. Kelly 8-28-90

Signature Date

WISCONSIN
WILLIAM F. KELLY
S1098
ELCHO, WIS.
LAND SURVEYOR

Index No. N-15

Stamp
35113400020