

CERTIFIED LAND CORNER RESTORATION

Index No. **X-16**



State of Wisconsin

County of Oneida } ss.

I Phillip T. Hansen, do hereby certify that on the 16th day of March, 1976, I found evidence of the EC 1/16 corner of Section 34 Township 35, North, Range 11 East, Fourth Principal Meridian, as described hereon; and that from this evidence I established a new monument and accessories as described hereon to perpetuate the original location of this corner.

Resident witnesses:

Glen Barker
Jim Clafin
Herb Wagoner

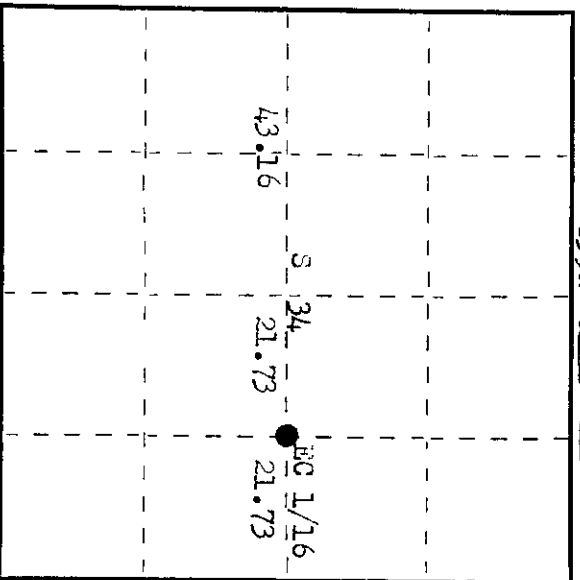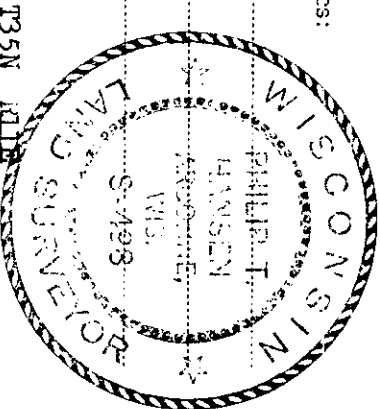

○ = Corner monument restored.

CERTIFIED LAND CORNER RESTORATION

History of original corner establishment:

H. C. Lawrence ran the E-W 1/4 line, commencing at the 1/4 Corner between Section 34 and 35, S 89° W mag. at 21.72 chains recovered on old stake, 7 lks North, believed to have been set by Clayton Vaughan. Continued west and at 43.46 chains, the C 1/4 corner was recovered 22 lks North. Set a new post for EC 1/16 equidistant at 21.73 chains. Marked NBT. N. Pine 14" S 60° E 119 lks. N. Pine 10" N 76 1/2° E 88 1/2 lks.

Description of corner evidence found:

Recovered an old squared stake, but no evidence of Lawrence's scribed post. Recovered OBT. N. Pine 14" (18") S 60° E (S 62° E) 119 lks. Scribed EC 1/16 BT. N. Pine 10" (14") N 76 1/2° E (N 75° E) 88 1/2 lks. Scribed EC 1/16 S 34 BT. This old post fits H.C. Lawrence's BTs.

Description of monument and accessories I established to perpetuate the original location of this corner.
Replaced old post with 1 1/2" OD iron pipe with 2" brass cap. Stamped.
Pipe projects 1 ft. above ground.
No additional accessories established.
Pipe and OBTs painted blue.

S498
T35N R11E
EC 1/16 21.73
CPI - 1976

Dated at Thiendale, Wis., this 19th day of March, 1976.

Signature Phillip T. Hansen Title Registered Land Surveyor Registration No. S-498
(County Surveyor, Registered Land Surveyor, or other duly authorized official)

Office of Register of Deeds, County of Oneida
Instrument was filed in this office for record on the 5th day of April, 1976
at 1:30 o'clock P. M. I hereby certify that the within

Debra Terage Kuehn
(Register of Deeds)

By: _____ Deputy

351134 2010