


# U.S. PUBLIC LAND SURVEY MONUMENT RECORD

Note: This form is intended and designed to fulfill all requirements of Wisconsin Administrative Code, Chapter A-E 7.08 U.S. Public Land Survey Monument Record (3) (a) (b) (c) (d) (e) (f) (g) (h) (i). An additional sheet may be added if necessary to conform with said requirements.

(a) Corner location: Township 35 North  
 Range 11 East/West  
 Town/City/Village SCHOEPKE  
 County ONEIDA

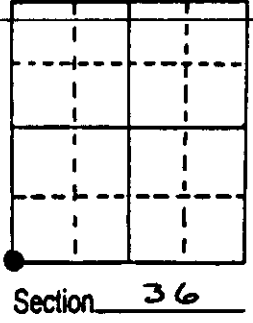


(b) (f) (g) (h) Description of monument found at this corner and if it was accepted, state all evidence (material, testimonial, occupational, plats, records, other monuments) used as a basis for accepting. If not accepted or if nothing was found, state evidence used as basis for establishing location. If reestablished through lost corner proportionate methods, indicate all monuments, distances and directions used to establish. Indicate type of monument found or set and sign post.

1857 - ALFRED MILLARD ESTABLISHED ORIGINAL CORNER; BT'S: 16" R. OAK, N5°W, 87 LKS.  
 10" Spruce, N63°E, 20 LKS  
 8" Spruce, S16°E, 178 LKS.  
 8" ASPEN, S23°W, 122 LKS.

1990 - I FOUND NO EVIDENCE OF CORNER OR BEARING TREES.  
 SET CORNER BY SINGLE PROPORTION. CORNER LANDS IN GRAVEL ON EAST EDGE COUNTY HWY. Z, I SET A 1/4" IRON PIPE 6" BELOW SURFACE & A 3" AL. WITNESS MONUMENT EAST 21.00 FEET

\* SEE OPPOSITE SIDE FOR DIRECTION & DISTANCES USED FOR PROPORTIONING BETWEEN FOUND CORNERS.

(c) (d) (e) Plan view of corner with ties to at least 4 witness monuments. If in disagreement with previously established corner, show the distances between the two corners and also indicate the ties to the disputed corner.

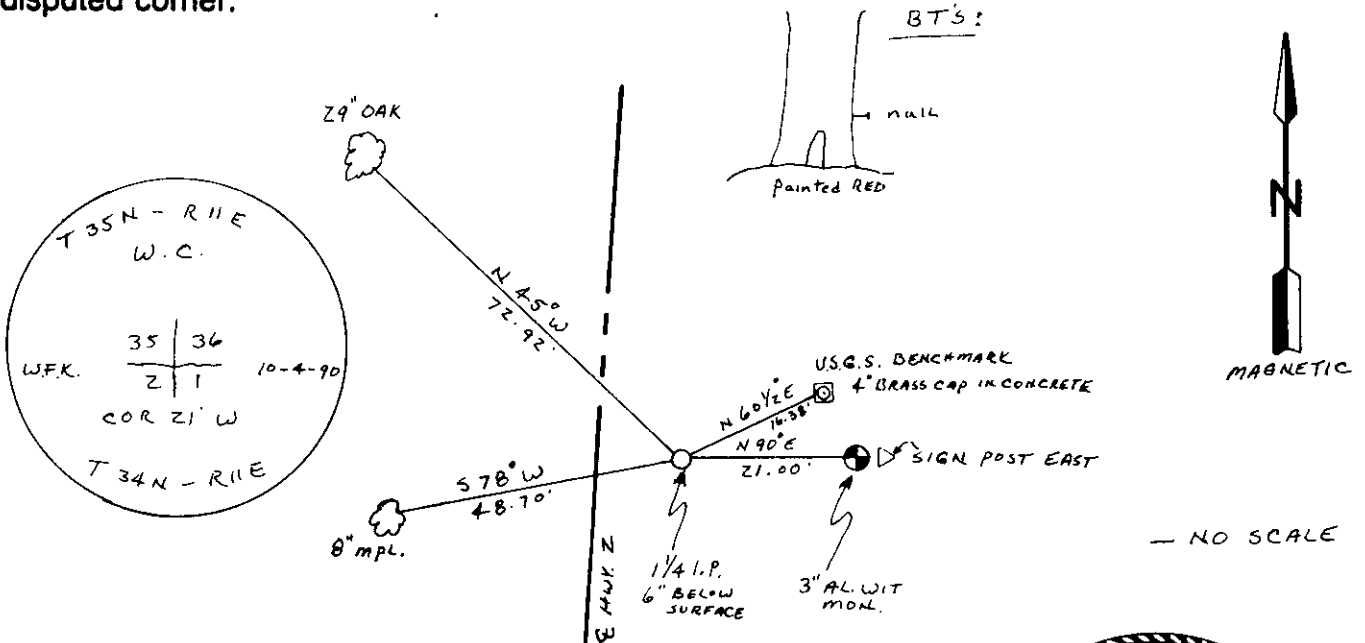

(i) I, WILLIAM F. KELLY  
 (type or print name) certify that the corner location on this record was determined by me or under my direction and control and that this U.S. Public Land Survey Monument Record is correct and complete to the best of my knowledge and belief.


William F. Kelly Signature  
10-30-90 Date



Stamp  
 3511350000

Index No. N-21

T 35 N - R 11 E

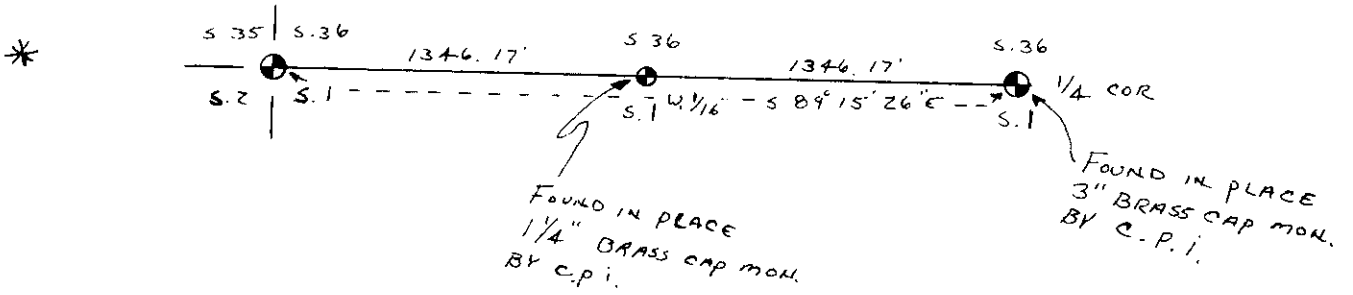

T 34 N - R 11 E

