

CERTIFIED LAND CORNER RESTORATION

Index No. Z-24

History of original corner establishment:

Corner established by H.C. Lawrence, Registered Land Surveyor, in 1958. From re-established 1/4 corner between Sections 36 and 1, he ran East (mag.) 41.75 chains to close out 2.52 chains north of Township Corner. Set a 4" cedar post for E 1/16, 126 links south of 20.87 1/2 chains intermediate. Corrected bearing of line S 86° 30' E. Marked Ash 1 1/4" N 25° W 23 links, cedar 6" S 35° E 19 links.

Description of corner evidence found:

Recovered 4" cedar post, squared and scribed E 1/16 S1, E 1/16 S36 in poor condition. Recovered OBT - Ash 1 1/4" N 25° W 23 links, scribed BT, now a 7' stub. Cedar 6" S 35° E 19 links, scribed S1 BT, now blown down.

Description of monument and accessories I established to perpetuate the original location of this corner.

Replaced 4" cedar post with 1 1/2" iron pipe with brass cap, stamped: 5498 T35N R11E Monument projects 16" above ground. NBT - Cedar 9" S 17° W 38.3 links, scribed 1/16 BT. Cedar 6" N 12° W 59.9 links, scribed 1/16 BT. Drove support stakes beside monument in muck and set old post beside it. E 1/16 S 1 T34N R11E CPI-1976

State of Wisconsin

County of Oneida } ss.



I Phillip T. Hansen, do hereby certify that on the 17th day of November, 19 76, I found evidence of the E 1/16 corner of Section 36 and 1 Township 35 & 34, North, Range 11 East, Fourth Principal Meridian, as described hereon; and that from this evidence I established a new monument and accessories as described hereon to perpetuate the original location of this corner.

Resident witnesses:

Glen Barker

Jim Clafin

Herb Wagoner

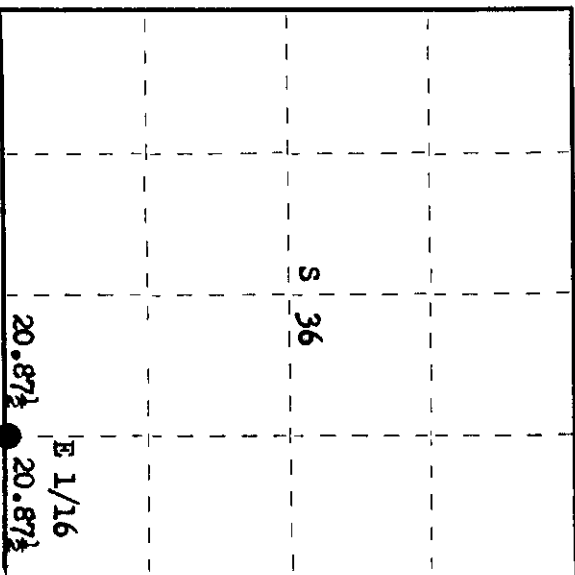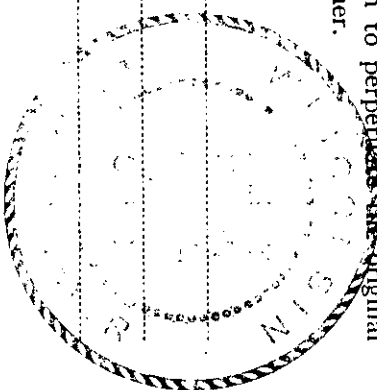

○ = Corner monument restored.

Dated at Rhinelander, Wis., this 6th day of December, 19 76.

Signature: Phillip T. Hansen Title: Registered Land Surveyor Registration No. S-498  
(County Surveyor, Registered Land Surveyor, or other duly authorized official)

Office of Register of Deeds, County of Oneida. I hereby certify that the within instrument was filed in this office for record on the 20th day of December, 19 76 at 10:00 o'clock A.M.

Signature: Barbara W. Kuehn (Register of Deeds)

By: \_\_\_\_\_ Deputy

3511360010