

CERTIFIED LAND CORNER RESTORATION

Index No. **Y-23**

State of Wisconsin

County of Oneida } ss.

I Phillip T. Hansen do hereby

certify that on the 17th day

of November, 1976, I found

evidence of the SC 1/16

corner of the Section 36

Township 35, North, Range

11 East, Fourth Principal Meridian,

as described hereon; and that from this evidence

I established a new monument and accessories

as described hereon to perpetuate the original


location of this corner.

Resident witnesses:


Glenn Barker

Jim Clarlin

Herb Wagoner

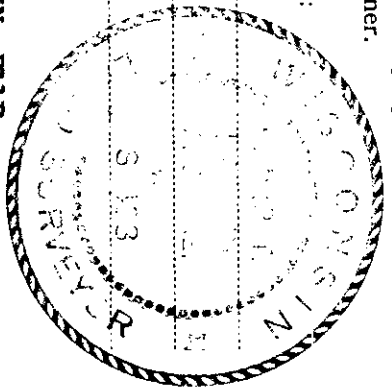

T35N R1E

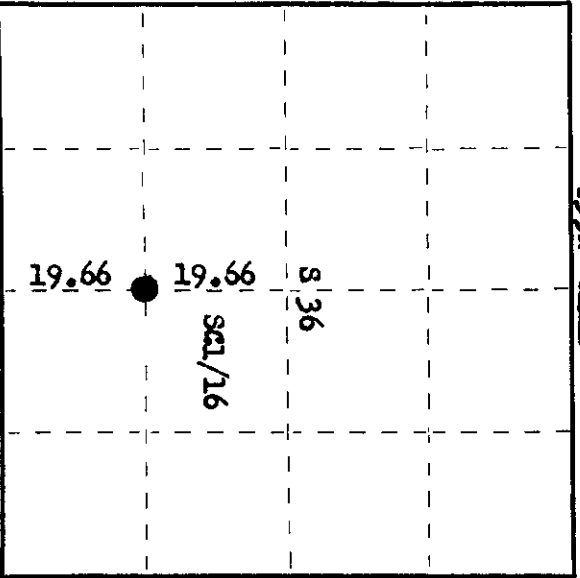

○ = Corner monument restored.

History of original corner establishment:

Corner established by H.C. Lawrence, Registered Land Surveyor, in 1953. From previously established C 1/4 corner, ran south (mag.) at 19.69 chains, found old SC 1/16 15 links east, at 39.32 chains S 1/4 corner was 24 links east. Set 4" oak post for SC 1/16, at 19.66 chains, intermediate 12 links east. Marked NBT - Old Pine BT S 20° E 31 1/2 links and Oak 4" S 60° E 18 1/2 links.

Description of corner evidence found:

Recovered 4" oak post, squared and scribed SC 1/16 S36, SC 1/16 S36 laying on ground. Found old point intact in ground. Also found piece of an old post laying beside it. Recovered old pine stump S 20° E 31.5 links. Red Oak 4" (6") S 60° E 18.5 links, scribing partly visible.

Description of monument and accessories I established to perpetuate the original location of this corner.

Replaced point of oak post, with 1 1/2" OD iron pipe with 2" brass cap, stamped: Monument projects 24" above ground. Marked NBT - Maple 6" N 19° W 47.5 links, scribed 1/16 BT.

S498
T35N R1E
SC 1/16 S 136
CPI-1976

Dated at Rhineland, Wis., this 6th day of December, 1976

Signature: Phillip T. Hansen Title: Registered Land Surveyor Registration No. S-498
(County Surveyor, Registered Land Surveyor, or other duly authorized official)

Office of Register of Deeds, County of Oneida. I hereby certify that the within instrument was filed in this office for record on the 20th day of December, 1976 at 102 o'clock P. M.

Doris Neugebauer
(Register of Deeds)

By: _____ Deputy

071361020