

CERTIFIED LAND CORNER RESTORATION

Index No. **X-24**

State of Wisconsin

County of **Ozida**

ss.

I **Phillip T. Hansen**, do hereby

certify that on the **29th** day

of **November**, 19 **76**, I found

evidence of the **EC 1/16**

corner of **Section 36**

Township **35**, North, Range

**11 East**, Fourth Principal Meridian,


as described hereon; and that from this evidence I established a new monument and accessories as described hereon to perpetuate the original location of this corner.

Resident witnesses:


**Glen Barker**

**Jin Craftin**

**Herb Wagener**

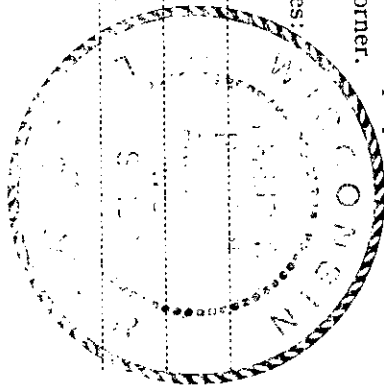

**T35N R11E**

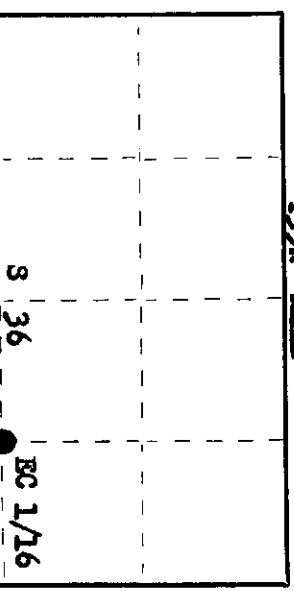

○ = Corner monument restored.

History of original corner establishment:

Corner recovered by H.C. Lawrence, Registered Land Surveyor, in 1959. From E 1/4 corner ran a random line N 86° 30' W, at 20.50 closed out 16 links north of old rotted off cedar post. Recovered OBTs - Yellow Birch 24" S 80° W 23 links and White Pine 18" S 60° E 35 links, both standing. Found scribe marks by cutting out 5" deep. Set new post, but made no NBTs.

Description of corner evidence found:

Recovered 4" cedar post, squared and scribed EC 1/16 S 36, 1/16 S36 in fair condition.  
Recovered OBTs - Yellow Birch 24" (28") S 80° W (S 83° W) 23 links, scribed 1/8 S.  
White Pine 18" S 60° E 35 links, scribed 1/8 S, now a cut off stump.

Description of monument and accessories I established to perpetuate the original location of this corner.

Replaced cedar post with 1 1/2" OD iron pipe with brass cap stamped:  
Monument projects 24" above ground. **S498**  
NBTs - Sugar 8" S 44° E 49 links, scribed 1/16 BT. **T35N R11E**  
Sugar 10" N 33° W 51 links, scribed 1/16 BT. **EC 1/16 S 136**  
**CPT-1976**


Signature *Phillip T. Hansen* Title **Registered Land Surveyor** Registration No. **S-498**  
(County Surveyor, Registered Land Surveyor, or other duly authorized official)

Office of Register of Deeds, County of **Ozida** *at* day of *December*, 19 *76*  
Instrument was filed in this office for record on the *10* day of *December*, 19 *76*  
at *10* o'clock *P*. M.

*Gene Neugebauer*  
(Register of Deeds)

By \_\_\_\_\_ Deputy

3511362010