

CERTIFIED LAND CORNER RESTORATION

Index No. W-24

State of Wisconsin }
County of Oneida } ss.



I Phillip T. Hansen, do hereby
certify that on the 30th day
of November, 1976, I found
evidence of the NE 1/16
corner of Section 36
Township 35, North, Range
11 East, Fourth, Principal Meridian,
as described hereon and that from this evidence
I established a new monument and accessories
as described hereon to perpetuate the original
location of this corner.

Resident witnesses:

Glenn Barker

Jim Glastin

Herb Wagoner

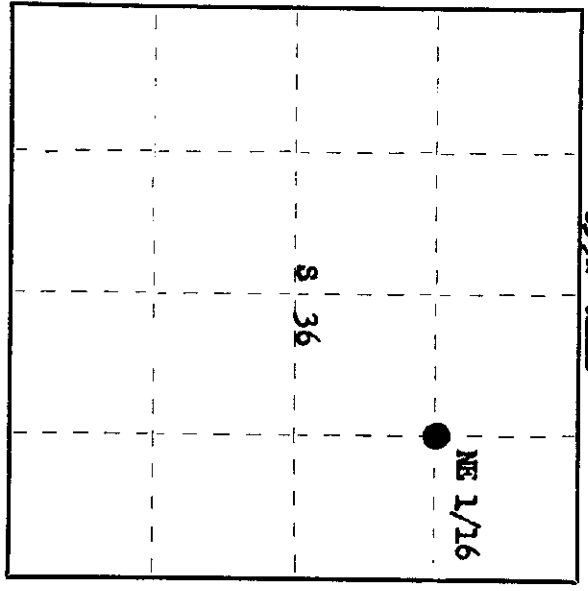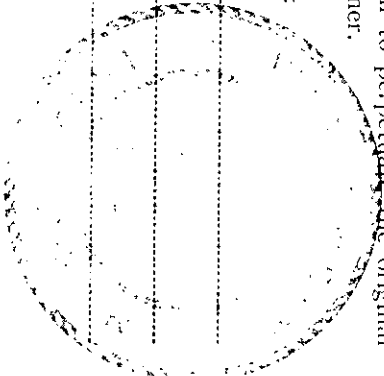

○ = Corner monument restored.

History of original corner establishment:

Corner restored by H.C. Lawrence, Registered Land Surveyor, in 1959.
From NE 1/16 corner, he ran S 86° 30' E from NE 1/16 corner 20.64 chains to old NE 1/16
post 1/4 links south. Recovered old Yellow Birch BT standing green 16" diameter, S 75° E
31 links.
Marked NBTs - Hemlock 1/4" N 75° W 5/4 links.
Cedar 1/4" S 20° W 4 7/8 links.

Description of corner evidence found:

Recovered 4" cedar post, squared and scribed NE 1/16 S36, NE 1/16 S36 in poor condition.
Also recovered an old cedar stake laying beside it.
Recovered OBT - Yellow Birch 16" S 75° E 31 links, scribed BT - now a 30" stub.
Hemlock 1/4" (16") N 75° W 5/4 links, scribed S36 BT.
Cedar 1/4" S 20° E 47.5 links, scribed NE 1/16 BT.

Description of monument and accessories I established to perpetuate the original location of this corner.
Replaced with 1 1/2" OD iron pipe with 2" brass cap stamped:
Monument projects 24" above ground.
Built rock cairn around base.
No additional accessories established.

S498
T35N R11E
NE 1/16 S 36
CPL-1976

Dated at Orineland, Wis., this 13th day of December, 1976

Signature Phillip T. Hansen Title Registered Land Surveyor Registration No. 3498
(County Surveyor, Registered Land Surveyor, or other duly authorized official)

Office of Register of Deeds, County of Oneida
I hereby certify that the within
instrument was filed in this office for record on the 26th day of December, 1976
at 1:00 o'clock P. M.

Signature Richard R. Kuehn
(Register of Deeds)

By _____ Deputy

3511363010