

CERTIFIED LAND CORNER RESTORATION



Index No. W-23

State of Wisconsin }
County of Oneida } ss.

I Phillip T. Hansen, do hereby certify that on the 16th day of November, 1976, I found evidence of the NC 1/16 corner of Section 36 Township 35 North, Range 11 East, Fourth Principal Meridian,

as described hereon; and that from this evidence I established a new monument and accessories as described hereon to perpetuate the original location of this corner.

Resident witnesses:
Glen Barker
Jim Claflin
Herb Wagoner

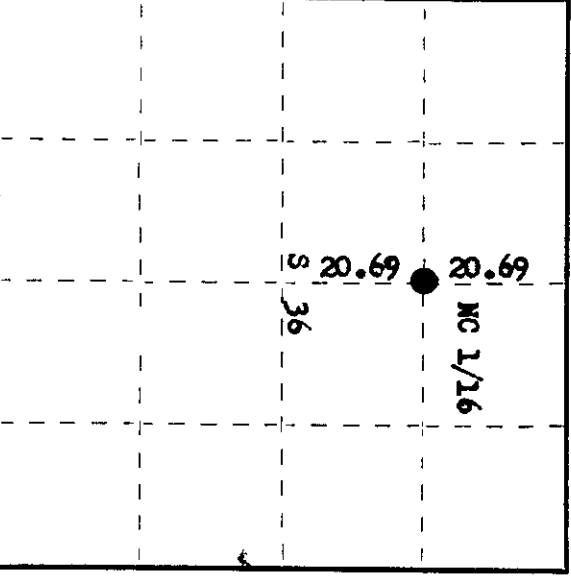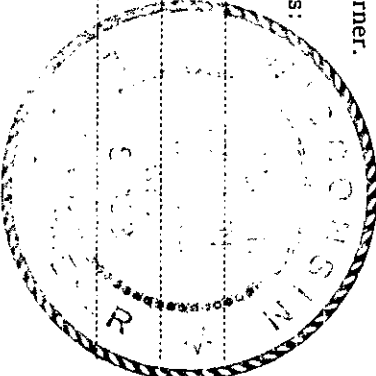

History of original corner establishment:

Corner established by H.C. Lawrence, Registered Land Surveyor, in 1958. From C 1/4 corner in fence corner he ran due north (mag.) in old fence line at 20.69 chains found an old NC 1/16 post lying down, partly covered with debris. A fence runs west from it. Set a new cedar post for NC 1/16 in hole of old post. Marked NBTs - Oak 9" N 70° E 59 links
Sugar 5" S 12° E 32 links

Description of corner evidence found:

Recovered 4" cedar post, squared and scribed NC 1/16 S36, NC 1/16. Post was in fair condition.
Recovered OBTs - Oak 9" (12") N 70° E (N 66° E) 59 links, scribed NC 1/16 BT. Sugar 5" (7") S 12° E 32 links, scribing grown over.

Description of monument and accessories I established to perpetuate the original location of this corner.

Replaced old cedar post with 1 1/2" OD iron pipe with 2" brass cap stamped:
Monument projects 18" above ground.
NBT - Sugar 8" N 58° W 34.7 links, scribed 1/16 BT.

\$4.98
T35N R11E
NC 1/16 S 1/36
CPI-1976

Dated at Rhinelander, Wis., this 3rd day of December, 1976

Signature Phillip T. Hansen Title Registered Land Surveyor Registration No. S-498
(County Surveyor, Registered Land Surveyor, or other duly authorized official)

Office of Register of Deeds, County of Oneida.
I hereby certify that the within instrument was filed in this office for record on the 20th day of December, 1976, at 10:00 o'clock P. M.

Deeie Heritage Kushar
(Register of Deeds)

By Deeie Heritage Kushar Deputy

351136 3020