
U.S. PUBLIC LAND SURVEY MONUMENT RECORD

Public Land	s intended and designed to fulfill all requirements of Wisconsin I Survey Monument Record (3) (a) (b) (c) (d) (e) (f) (g) (h) (i). An th said requirements.	n Administrative Code, Chapter A-E 7.08 U.S additional sheet may be added if necessary to
	tion: Township36 North	
	Range 4 East/West	
Town/City/Villag	e Lynne	
County	Oneida	
		Section1

- (b) (f) (g) (h) Description of monument found at this corner and if it was accepted, state all evidence (material, testimonial, occupational, plats, records, other monuments) used as a basis for accepting. If not accepted or if nothing was found, state evidence used as basis for establishing location. If reestablished through lost corner proportionate methods, indicate all monuments, distances and directions used to establish. Indicate type of monument found or set and sign post.
 - 9/3/1860 Alfred Millard established this corner at 80.00 chains and set a wood post: 24" Hemlock, N45°E, 30 Links (19.80') 20" Y. Birch, S10°E, 34 Links (22.44') 10" Hemlock, S42°W, 29 Links (19.14') 12" Hemlock, N10°W, 19 Links (12.54')
 - 10/10/1935 A.J. Lytle was here and ran East to tie in truck trail. Made new BT: 14" Hemlock, $S50\frac{1}{2}$ °E, $82\frac{1}{2}$ Links (54.45'). We found a 2" iron pipe with brass cap stamped to identify corner by "A.J. Lytle - Surv."
 - Milo E. Stefan found $2^{"}$ iron pipe/brass cap. No trace of any BTs. We made four new BTs and set plastic sign post. While at corner we did not know of Lytles BT in 1935. We, therefore, did not search for it.
- (c) (d) (e) Plan view of corner with ties to at least 4 witness monuments. If in disagreement with previously established corner, show the distances between the two corners and also indicate the ties to the disputed corner.
 - 2" x 60" Iron Pipe/Screw On Brass Cap.
 - 8" Sugar Maple, N37°E, 19.77'.
 - 3) 8" Sugar Maple, S3°E, 26.15'.
 - 4) 10" Sugar Maple, N76°W, 21.74'. 5) 8" Sugar Maple, N28°W, 33.39'.

 - 6) Plastic Sign Post, Northeast, 1.2'.

Distances to nail in side of BTs. Stump blaze scribed "BT".

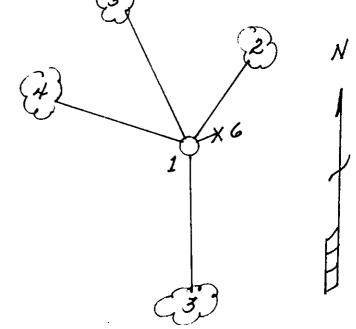

Milo E. Stefan

(type or print name) certify that the corner location on this record was determined by me or under my direction and control and that this U.S. Public Land Survey Monument Record is correct and complete to the best of my knowledge and belief.

Signature

August 2, 1994

Date



U.S. PUBLIC LAND SURVEY MONUMENT RECORD

Note: This form is intended and designed to fulfill all requirements of Wisconsin Administrative Code, Chapter A-E 7.08 U.S. Public Land Survey Monument Record (3)(a-i).


(a) CORNER LOCATION Cor. of Secs. 1, 6, 7 & 12 Township 36 North

Range 4 & 5 East of the 4th P.M. Towns of Lynne & Little Rice

County of Oneida

WISCRS - Oneida County N: 161,292.91 USft E: 133,795.13 USft Datum: NAD 83(2011)

GNSS Method: Real-Time Network GNSS Control: WISCORS VRS

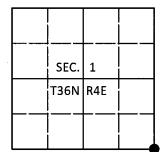

(b) HISTORY OF ORIGINAL CORNER ESTABLISHMENT

Original Surveyor:

Original Accessories:

Date of Survey

Commenced: Completed:


(b)(f)(g)(h) Description of monument found at this corner and if it was accepted, state all evidence (material, testimonial, occupational, plats, records, other monuments) used as a basis for accepting. If not accepted or if nothing was found, state evidence used as basis for establishing location. If re-established through lost corner proportionate methods, indicate all monuments, distances and directions used to establish. Indicate type of monument and sign post found or set.

This is a perpetuation of a previous USPLS Monument Record by Milo E. Stefan, RLS dated August 2, 1994 and filed in the office of the Oneida County Register of Deeds. A complete history of the corner can be found on the previous monument record. I accept the previous location as a true and faithful perpetuation or reestablishment of the original corner location and further perpetuate it as follows.

October 12, 2017: Jeff Austin visited the corner and recovered the record monument, a 2-1/2" diam. iron pipe with a 3" diam. Lytle brass cap projecting 24" above the ground surface. Stefan's tree at N28°W is now a stump. Accessories were found or established as shown below. A white vinyl sign post was found Northeast, 1.4 ft.

The coordinate value shown has been verified by at least one of the following methods: 1) comparison to a previously GPS determined published value; 2) the value is the average of two or more GPS observations at a markedly different time; 3) one or more distances were measured back to the GPS observed corner from temporary GPS observed offset locations.

(c)(d)(e) Plan view of corner with ties to at least 4 witness monuments. If in disagreement with previously established corner, show the distances between the two corners and also indicate the ties to the disputed.

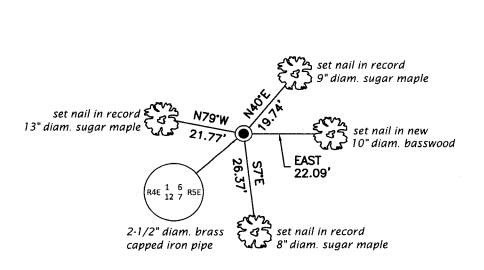

(i) I, Michael J. Romportl, Professional Land Surveyor No. S-1624, hereby certify that the corner location on this record was determined by me or under my direction and control and that this U.S. Public Land Survey Monument Record is correct and complete to the best of my knowledge and belief.

