


U.S. PUBLIC LAND SURVEY MONUMENT RECORD

Note: This form is intended and designed to fulfill all requirements of Wisconsin Administrative Code, Chapter A-E 7.08 U.S. Public Land Survey Monument Record (3) (a) (b) (c) (d) (e) (f) (g) (h) (i). An additional sheet may be added if necessary to conform with said requirements.

(a) Corner location: Township 36 North
 Range 4 EastWest


Town/City/Village Lynne
 County Oneida

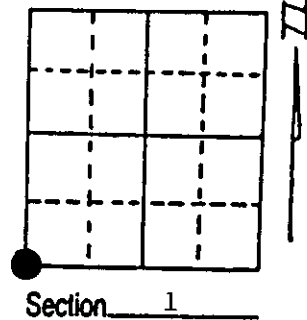

(b) (f) (g) (h) Description of monument found at this corner and if it was accepted, state all evidence (material, testimonial, occupational, plats, records, other monuments) used as a basis for accepting. If not accepted or if nothing was found, state evidence used as basis for establishing location. If reestablished through lost corner proportionate methods, indicate all monuments, distances and directions used to establish. Indicate type of monument found or set and sign post.

- May 1865 - Edward D. Palmer established this corner at 80.00 chains and set a wood post with four BTs:
 8" Birch, N56°E, 35 Links (23.1') 12" Pine, S44°E, 32 Links (22.12')
 ? Birch, S20°W, 35 Links (23.1') 10" Birch, N45°W, 33 Links (21.78')
 Called creek East 1.76 chains (116')
- 10/20/1896 - B.F. Dorr was here and ran North. No indication what he had at this corner. He ran North and hit creek at 2.90 chains (191').
- 9/21/1917 - D.H. VAUGHAN found Birch okay, Tamarack dead (this was the Pine). He made two new BTs and ran Westerly - left swamp at 4.5 chains.
- 12/13/1934 - A. J. Lytle ran from S½ of Section 1 West to this corner, found distance to be 40.05 chains. Set West 1/16 on South line of Section 1, did not say what he found or did here.
- 8/15/1994 - Milo E. Stefan found stumps of original 12" White Pine, S44°E, 22.1' and 16 - 20" Birch stump, S20°W, 21.8'. Other two originals gone. A Spruce stump is N45°W, 11.88'. (Did Vaughan switch species of trees?) He called the original 12" Pine a Tamarack. Creek calls East and North are very good. Swamp call West fits well. Our falling of the traverse from 1/4 through W 1/16 falls

(c) (d) (e) Plan view of corner with ties to at least 4 witness monuments. If in disagreement with previously established corner, show the distances between the two corners and also indicate the ties to the disputed corner. S60°W, 18 feet. I accept the stumps of the Pine and SW Birch as evidence of the original corner and restored this corner from this evidence. We set a 2" x 5' aluminum monument, made four new BTs and set a plastic sign post.

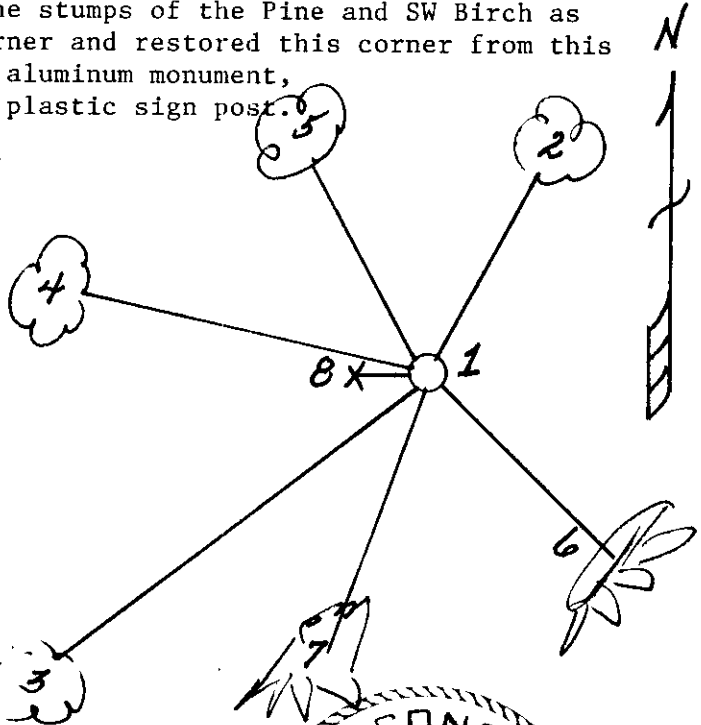

- 1) 2" x 5' Aluminum Oneida County Monument.
- 2) 5" White Birch, N22°E, 34.47'.
- 3) 10" Tamarack, S38°W, 173.90'.
- 4) 5" Tamarack, N82°W, 83.77'.
- 5) 3" Tamarack, N36°W, 55.02'.
- 6) Rotten Pine Stump, S45°E, 22.12'.
- 7) Rotten Birch Stump, S20°W, 23.10'.
- 8) Plastic Sign Post, West, 1.0'.
- 9) 10" Spruce, S46°E, 27 Lks (17.82').
- 10) 9" Hemlock, N45°W, 18 Lks (11.88').

Distances to nail in side of BTs.
 Stump blazes scribed "BT".

(i) I, Milo E. Stefan
 (type or print name) certify that the corner location on this record was determined by me or under my direction and control and that this U.S. Public Land Survey Monument Record is correct and complete to the best of my knowledge and belief.

Milo E Stefan
 Signature

August 16, 1994
 Date



Stamp 3604020000

Index No. E-21