


U.S. PUBLIC LAND SURVEY MONUMENT RECORD

Note: This form is intended and designed to fulfill all requirements of Wisconsin Administrative Code, Chapter A-E 7.08 U.S. Public Land Survey Monument Record (3)(a)(b)(c)(d)(e)(f)(g)(h)(i). An additional sheet may be added if necessary to conform with said requirements.

(a) CORNER LOCATION:
 1/4 Cor. of Secs. 2 & 3
 Township 36 North
 Range 4 East of the 4th P.M.
 Town of Lynne

Plane Coordinates
 X:
 Y:
 Datum:
 County of Oneida

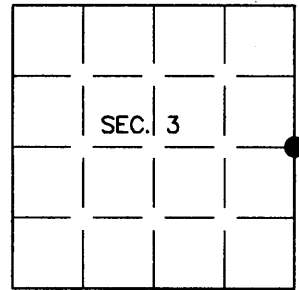


(b) HISTORY OF ORIGINAL CORNER ESTABLISHMENT

Original Surveyor: Edward Palmer
 Date of Survey: Commenced May, 1865
 Completed June, 1865


Original Accessories:
 Cedar 5" S--W, 10 lks.
 Fir 4-1/2" N35E, 14 lks.

(b)(f)(g)(h) Description of monument found at this corner and if it was accepted, state all evidence (material, testimonial, occupational, plats, records, other monuments) used as a basis for accepting. If not accepted or if nothing was found, state evidence used as basis for establishing location. If re-established through lost corner proportionate methods, indicate all monuments, distances and directions used to establish. Indicate type of monument and sign post found or set.

12 June 2006: I found and accepted a 2-1/2 ins. diam. iron post with brass cap projecting 24 ins. above the bog surface. No evidence of any survey activity remains at this corner, but the monument is similar in character to those found at other reliable corners throughout the county forest. I established accessories as shown below and set a white plastic sign post bearing Northeast, 1 ft. dist.

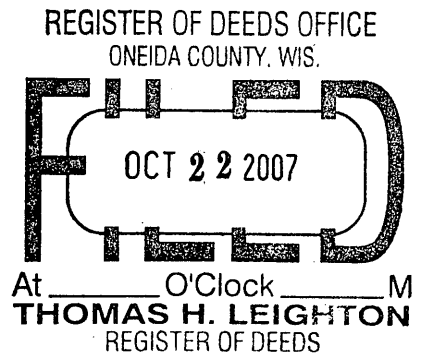


(c)(d)(e) Plan view of corner with ties to at least 4 witness monuments. If in disagreement with previously established corner, show the distances between the two corners and also indicate the ties to the disputed.

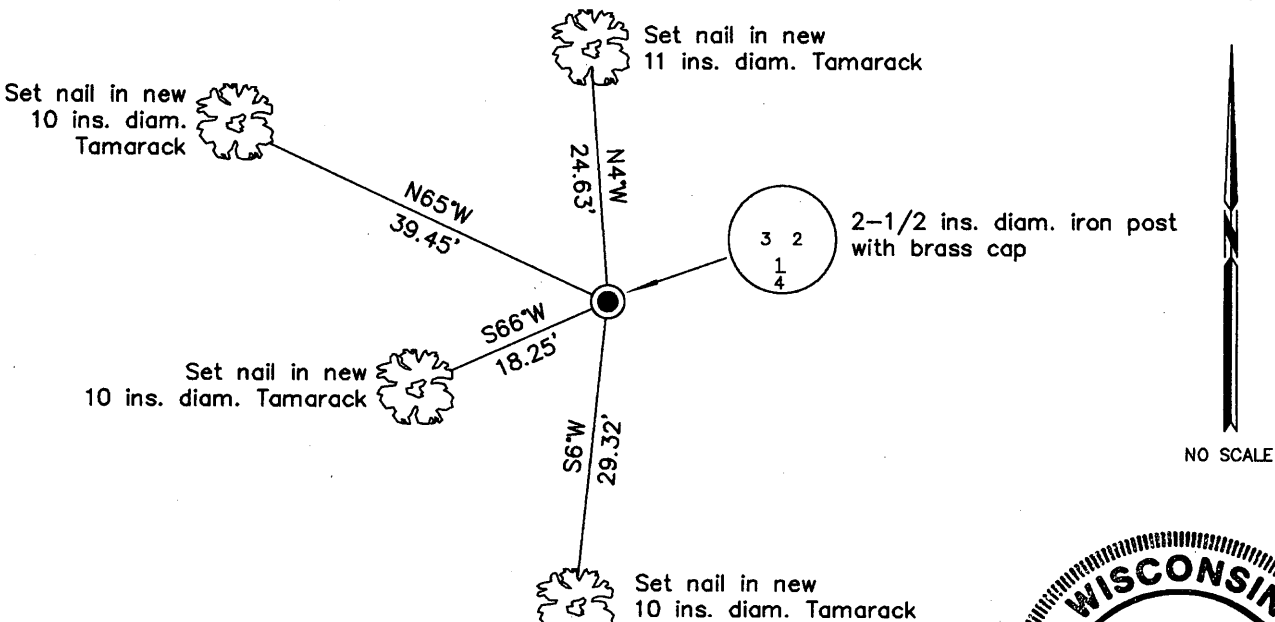

(i) I, Jeffrey W. Austin, Registered Land Surveyor No. S-1885, hereby certify upon honor that the corner location on this record was determined by me or under my direction and control and that this U.S. Public Land Survey Monument Record is correct and complete to the best of my knowledge and belief.

Signature

OCT 8, 2007
 Date

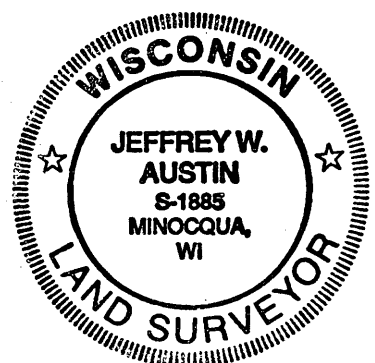

INDEX NO. C-17 (3604032000)