U.S. PUBLIC LAND SURVEY MONUMENT RECORD

Note: This form is intended and designed to fulfill all requirements of Wisconsin Administrative Code, Chapter A-E 7.08 U.S. Public Land Survey Monument Record (3)(a-i).

(a) CORNER LOCATION
Cor. of Secs. 19, 24, 25 & 30
Township 36 North
Range 4 & 5 East of the 4th P.M.
Town of Lynne/Little Rice
County of Oneida

WISCRS - Oneida County
N: 145,391.25 USft
E: 133,801.46 USft
Datum: NAD 83(2011)
GNSS Method: Real-Time Network
GNSS Control: WISCORS VRS

	SEC.	24	
	T36N	R4E	

(b) HISTORY OF ORIGINAL CORNER ESTABLISHMENT

Original Surveyor: Alfred Millard

Date of Survey Commenced: Aug., 1860
Completed: Sep., 1860

Original Accessories:
Cedar 10 S32°W, 28 lks.
Spruce 12 N40°E, 12 lks.
Y.Birch 10 S70°E, 16 lks.
Y.Birch -- N75°W, 75 lks.

(b)(f)(g)(h) Description of monument found at this corner and if it was accepted, state all evidence (material, testimonial, occupational, plats, records, other monuments) used as a basis for accepting. If not accepted or if nothing was found, state evidence used as basis for establishing location. If re-established through lost corner proportionate methods, indicate all monuments, distances and directions used to establish. Indicate type of monument and sign post found or set.

March 5, 2018: Previously, Jeff Austin thoroughly searched this corner along with 3604242000 and 3604252000 and found them all to be lost corners with no evidence of the GLO survey or any subsequent survey in existence. From the proportioned point, the distance East to the creek is 1.50 chains, agreeing with the GLO record. The distance North to the creek would agree well with the GLO record were it not for the beaver pond. As detailed below, a 1" diam., 30" long aluminum pipe with a 2-1/2" diam. Oneida Co. aluminum cap flush with the ground surface was set at the proportionate distance between controlling corners. Accessories were established as shown below. A white vinyl sign post was set Northwest, 1 ft.

The coordinate value shown has been verified by at least one of the following methods: 1) comparison to a previously GPS determined published value; 2) the value is the average of two or more GPS observations at a markedly different time; 3) one or more distances were measured back to the GPS observed corner from temporary GPS observed offset locations.

(c)(d)(e) Plan view of corner with ties to at least 4 witness monuments. If in disagreement with previously established corner, show the distances between the two corners and also indicate the ties to the disputed.

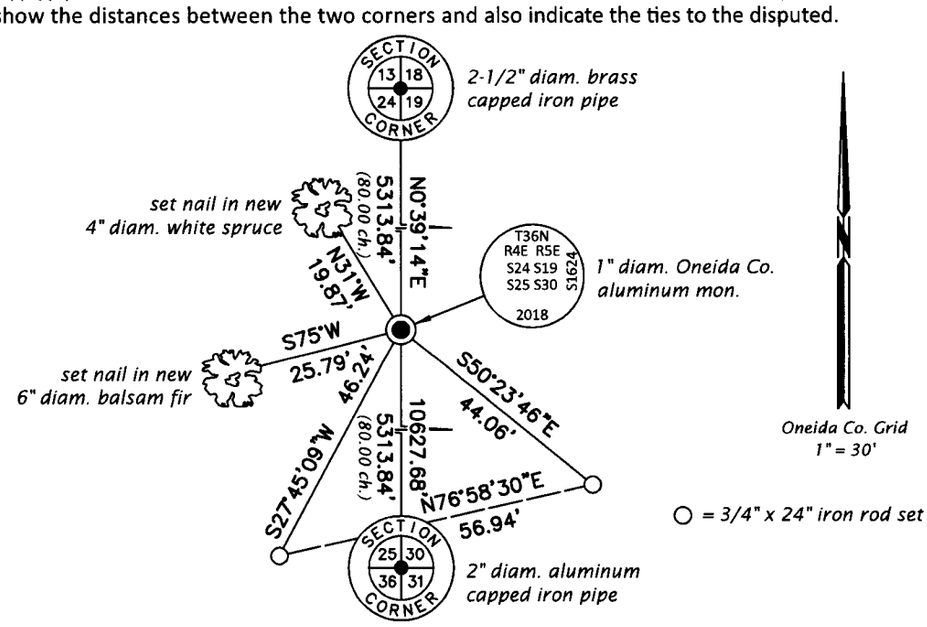

REGISTER OF DEEDS OFFICE
ONEIDA COUNTY
FILED

MAR 15 2018

KYLE J. FRANSON
REGISTER OF DEEDS

(i) I, Michael J. Romportl, Professional Land Surveyor No. S-1624, hereby certify that the corner location on this record was determined by me or under my direction and control and that this U.S. Public Land Survey Monument Record is correct and complete to the best of my knowledge and belief.

WISCONSIN MICHAEL J. ROMPORTL S-1624 RHINELANDER, WI LAND SURVEYOR

Michael J. Romportl 3/12/2018
Signature Date

3604240000 (INDEX NO. R-25)