U.S. PUBLIC LAND SURVEY MONUMENT RECORD

Note: This form is intended and designed to fulfill all requirements of Wisconsin Administrative Code, Chapter A-E 7.08 U.S. Public Land Survey Monument Record (3)(a)(b)(c)(d)(e)(f)(g)(h)(i). An additional sheet may be added if necessary to conform with said requirements.

(a) CORNER LOCATION:
1/4 Cor. of Secs. 31 & 32
Township 36 North
Range 4 East of the 4th P.M.
Town of Lynne

Oneida County Coordinates
N: 137,498.803 USft
E: 107,446.338 USft
Datum: NAD 1983(1991)
County of Oneida

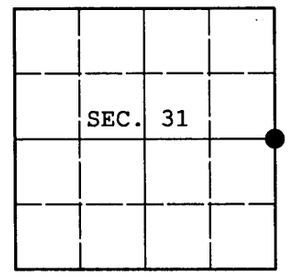

(b) HISTORY OF ORIGINAL CORNER ESTABLISHMENT

Original Surveyor: Edward D. Palmer
Date of Survey: Commenced: May 27, 1865
Completed: June 4, 1865

Original Accessories:
alder 3" N70°W, 19 lks.
fir 9" S61°E, 72 lks.

(b)(f)(g)(h) Description of monument found at this corner and if it was accepted, state all evidence (material, testimonial, occupational, plats, records, other monuments) used as a basis for accepting. If not accepted or if nothing was found, state evidence used as basis for establishing location. If re-established through lost corner proportionate methods, indicate all monuments, distances and directions used to establish. Indicate type of monument and sign post found or set.

May 30, 1905: Notes by Vaughan in Dorr/Vaughan book on page 2 indicate he recovered the original corner during the course of a road survey for the Town of Lynne.

December 5, 2012: An extensive search for evidence of the General Land Office survey and any subsequent resurveys mentioned above was performed. Having found none, the corner was positioned at the intersection of the centerlines of Ahola Road and Town Hall Road. The distances from this corner to 3604310000 and 3604322000 agree with Vaughan's distances very favorably. At the corner point a 3/4" diam., 24" long iron rod was set 8" beneath the road surface. Accessories were established as shown below and white plastic sign posts were set adjacent to the northerly reference monuments.

The coordinates shown were derived from two independent RTK observations of the corner point and are based on the WISCORS network.

(c)(d)(e) Plan view of corner with ties to at least 4 witness monuments. If in disagreement with previously established corner, show the distances between the two corners and also indicate the ties to the disputed.

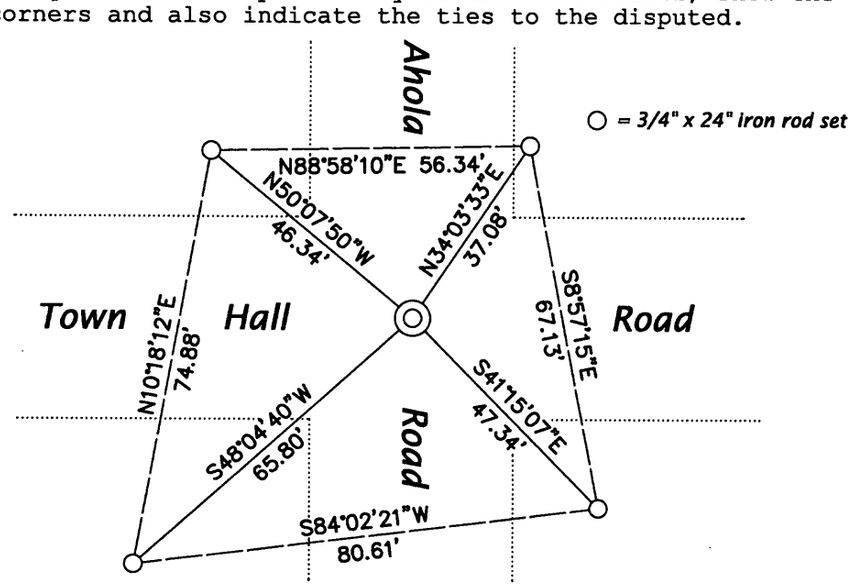

REGISTER OF DEEDS OFFICE
ONEIDA COUNTY
FILED

APR 15 2013

AT_____O'CLOCK_____M
KYLE J. FRANSON
REGISTER OF DEEDS

(i) I, Michael J. Romportl, Registered Land Surveyor No. S-1624, hereby certify that the corner location on this record was determined by me or under my direction and control and that this U.S. Public Land Survey Monument Record is correct and complete to the best of my knowledge and belief.

WISCONSIN
MICHAEL J. ROMPORTL
S-1624
RHINELANDER, WI
LAND SURVEYOR

Michael J Romportl 2/12/2013
Signature Date

3604312000 (INDEX NO. X-5)