

U.S. PUBLIC LAND SURVEY MONUMENT RECORD


Note: This form is intended and designed to fulfill all requirements of Wisconsin Administrative Code, Chapter A-E 5.02, U.S. Public Land Survey Monument Record (3) (a) (b) (c) (d) (e) (f) (g) (h) (i). An additional sheet may be added if necessary to conform with said requirements.

(a) Corner location: Township 36 North

Range 4 East/~~West~~

Town/~~City/Village~~ Lynne

County Oneida

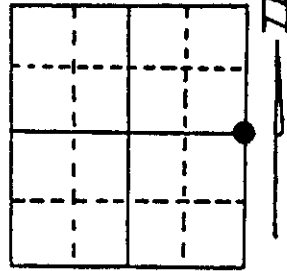

Section 35

(b) (f) (g) (h) Description of monument found at this corner and if it was accepted, state all evidence (material, testimonial, occupational, plats, records, other monuments) used as a basis for accepting. If not accepted or if nothing was found, state evidence used as basis for establishing location. If reestablished through lost corner proportionate methods, indicate all monuments, distances and directions used to establish.


Recovered the upper portion of V.A. Maine's 6" x 6" Cedar post laying on rock cairn, also the post point within the rock cairn. Corner sets in old North-South fence line.

V.A. Maine proportioned Quarter Section Corner Survey of 1937. No evidence of any old BTs as area was burned over at time of survey.

Replaced old post point with Oneida County Monument.


Original corner established by Edward D. Palmer, Gov't Deputy Surveyor in 1865, from which 12" Hemlock bears N14E, 28 lks. and 18" Hemlock bears S52W, 26 lks.

(c) (d) (e) Plan view of corner with ties to at least 4 witness monuments. If in disagreement with previously established corner, show the distances between the two corners and also indicate the ties to the disputed corner.

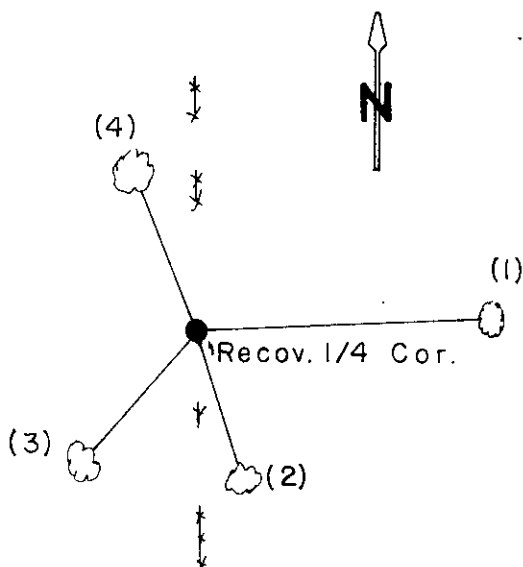


- | | | |
|-------------------------|-------|--------|
| (1) 8" Sugar Maple | N88°E | 46.46' |
| (2) 5" Twin Sugar Maple | S17°E | 24.43' |
| (3) 4" Sugar Maple | S43°W | 27.62' |
| (4) 12" White Birch | N20°W | 27.33' |

2-1/4" Alum. Oneida Co. Mon.
3-1/4" Alloy Cap

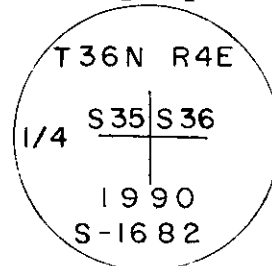

(i) I, Glen Barker
(type or print name) certify that the corner location on this record was determined by me or under my direction and control and that this U.S. Public Land Survey Monument Record is correct and complete to the best of my knowledge and belief.

Glen Barker Signature 11/4/91 Date

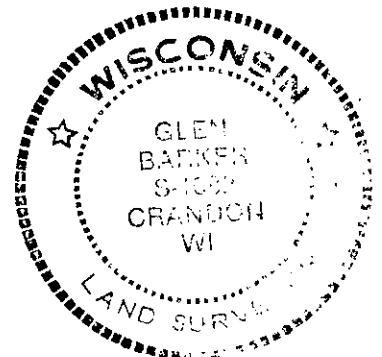

Index No. X-21

3604352000