


U.S. PUBLIC LAND SURVEY MONUMENT RECORD

Note: This form is intended and designed to fulfill all requirements of Wisconsin Administrative Code, Chapter A-E 7.08 U.S. Public Land Survey Monument Record (3) (a) (b) (c) (d) (e) (f) (g) (h) (i). An additional sheet may be added if necessary to conform with said requirements.

(a) Corner location: Township 36 North
 Range 5 East/West

Town/City/Village Little Rice

County Oneida

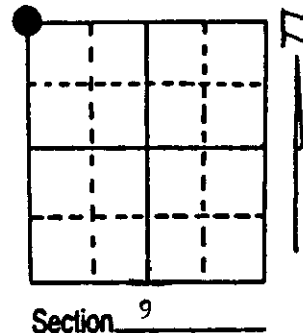


(b) (f) (g) (h) Description of monument found at this corner and if it was accepted, state all evidence (material, testimonial, occupational, plats, records, other monuments) used as a basis for accepting. If not accepted or if nothing was found, state evidence used as basis for establishing location. If reestablished through lost corner proportionate methods, indicate all monuments, distances and directions used to establish. Indicate type of monument found or set and sign post.

- 6/1863 - Joseph H. Jenkins established this corner. No BTs given in Jenkins notes.
- 1/15/1935 - A. J. Lytle found original Section Corner Post with notches in perfect state of preservation and two bearing trees with scribing marks:
 5" Tamarack, S31°E, 21 Links (13.86') 4" Cedar, N26°W, 42 Links (27.72')
 He made no new BTs. His traverse distance West was 7907.955 feet and South was 5371.74 feet.
- 2/22/1995 - Milo E. Stefan found a 2" x ?' (assumed 60") aluminum monument marked for corner with BTs. Our traverse gave a distance West of 7907.20' and South 5370.10'. I accept this monument as the Section Corner and restore same.

(c) (d) (e) Plan view of corner with ties to at least 4 witness monuments. If in disagreement with previously established corner, show the distances between the two corners and also indicate the ties to the disputed corner.

- 1) 2" Aluminum Monument
- 2) 6" Tamarack, N48°E, 93.52'
- 3) 5" Tamarack, S79°E, 21.48'
- 4) 6" Tamarack, S11°E, 56.00'
- 5) 4" Tamarack, N73°W, 47.12'
- 6) Plastic Sign Post, North, 1.0'

Distances to nail in side of BTs.
 Stump blaze scribed "BT".
 Bearing tree poster placed on each BT.

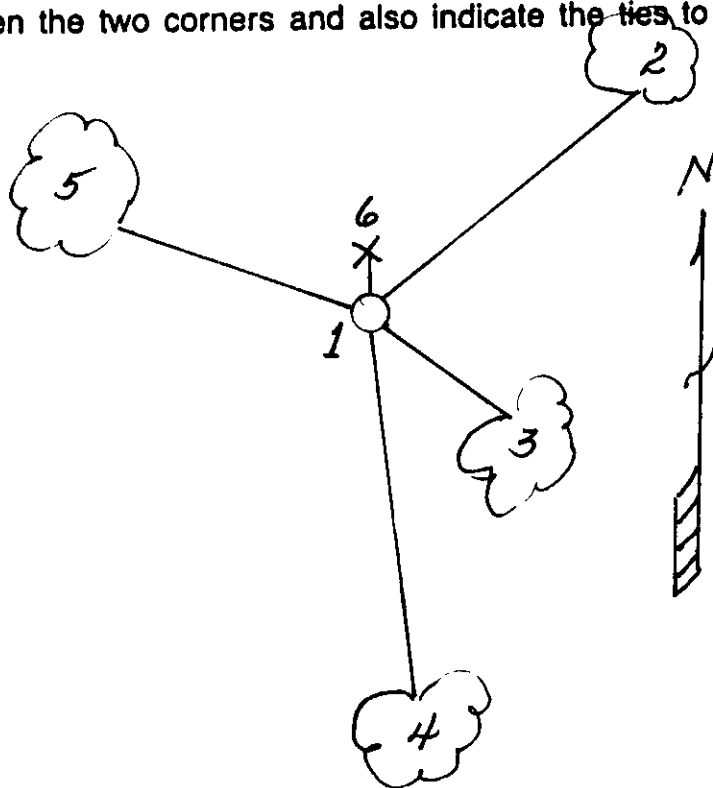

REGISTER OF DEEDS OFFICE
 ONEIDA COUNTY WIS
FILED
 MAY 23 1995
 At _____ O'Clock _____ M
THOMAS H. LEIGHTON
 REGISTER OF DEEDS

(i) I, Milo E. Stefan
 (type or print name) certify that the corner location on this record was determined by me or under my direction and control and that this U.S. Public Land Survey Monument Record is correct and complete to the best of my knowledge and belief.



Milo E. Stefan Signature Date May 8,, 1995

Index No. E-9

3605050000