

CERTIFIED LAND CORNER RESTORATION

State of Wisconsin }
County of Oneida } ss.

I, John H. Fisher, do hereby certify that on the 9th day of July, 1981, I found ~~evidence~~ ^{no evidence} of the west one quarter corner of Section 4 Township 36N, Range 5E, Fourth Principal Meridian, as described hereon; and that from this evidence I established a new monument and accessories as described hereon to perpetuate the original location of this corner:

Description of original monument and accessories and subsequent restorations:

The original Gov't. survey was performed by Joseph H. Jenkins Deputy Surveyor in June 1863.

Set wood post
5' Spruce N27°E 380 links
5' Spruce S42°W. 181 Links



Description of corner evidence found:

None

Description of monument and accessories I established to perpetuate the location of this corner:

Set Oneida County 2' aluminium pipe with stamped aluminium cap.

Tamarack post
12' Tamarack N47°W, 47.0 feet
4' Tamarack S72°W, 41.1 feet
6' Tamarack S34°W, 51.4 feet

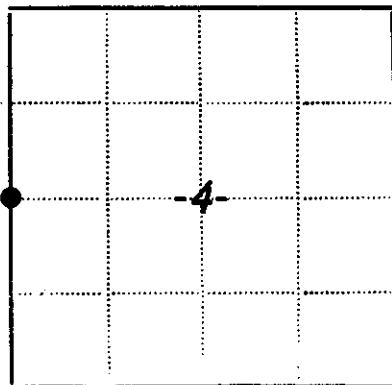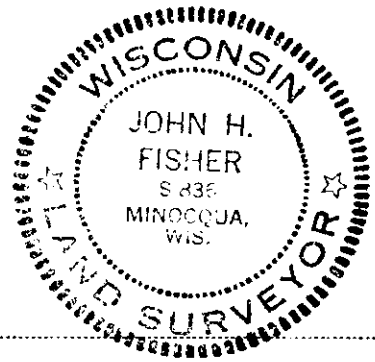

● - Corner monument restored
□ -

Resident witnesses.....

Dated at Minocqua Wisconsin, this 31 day of July 1981.

Signature John H. Fisher Title Registered Land Surveyor
(County Surveyor, Registered Land Surveyor, or other duly authorized official)

Surveyors Registration No. S-836

Office of REGISTER OF DEEDS County of Oneida

I hereby certify that the within instrument was filed in this office for record on the 17th day of September 1982, and was filed in Book No. Page No. of County Records.

Signature Doris Verage Kuehn Title REGISTER OF DEEDS

Township....., Range....., Section....., Index No....., Page No.....

6-9