

U.S. PUBLIC LAND SURVEY MONUMENT RECORD


Note: This form is intended and designed to fulfill all requirements of Wisconsin Administrative Code, Chapter A-E 7.08 U.S. Public Land Survey Monument Record (3) (a) (b) (c) (d) (e) (f) (g) (h) (i). An additional sheet may be added if necessary to conform with said requirements.

(a) Corner location: Township 36 North

Range 5 East/West

Town/City/Village Little Rice

County Oneida

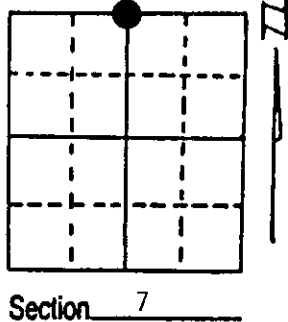

(b) (f) (g) (h) Description of monument found at this corner and if it was accepted, state all evidence (material, testimonial, occupational, plats, records, other monuments) used as a basis for accepting. If not accepted or if nothing was found, state evidence used as basis for establishing location. If reestablished through lost corner proportionate methods, indicate all monuments, distances and directions used to establish. Indicate type of monument found or set and sign post.

6/1863 - Joseph H. Jenkins established this corner at 39.40 chains and set a wood post for Quarter Corner with two BTs;

8" Birch, S11°E, 21 Links (13.86') 10" Birch, N22°W, 40 Links (26.40')

1/10/1935 - A.J. Lytle restored corner at mid-point and one line between Section Corners East and West. (This was wrong method!) He made two new BTs:

6" Cedar, N27½°W, 6¼ Links (4.12') 9" Cedar, S41½°W, 6 Links (3.96')


7/28/1994 - Milo E. Stefan found 2" x 60" iron pipe with unmarked brass cap. Lytle

Southwest BT now 16" Cedar, S42°W, 4' (unmarked). We made four new BTs and set plastic sign post.

(c) (d) (e) Plan view of corner with ties to at least 4 witness monuments. If in disagreement with previously established corner, show the distances between the two corners and also indicate the ties to the disputed corner.

- 1) 2" x 60" Iron Pipe/Brass Cap.
- 2) 8" Sugar Maple, S15°W, 40.96'.
- 3) 12" Sugar Maple, S60°W, 35.10'.
- 4) 8" Sugar Maple, N57°W, 41.38'.
- 5) 18" Cedar, N17°W, 13.36'.
- 6) Plastic Sign Post, Southeast, 1.0'.

Distances to nail in side of BTs.
Stump blazes scribed "BT".

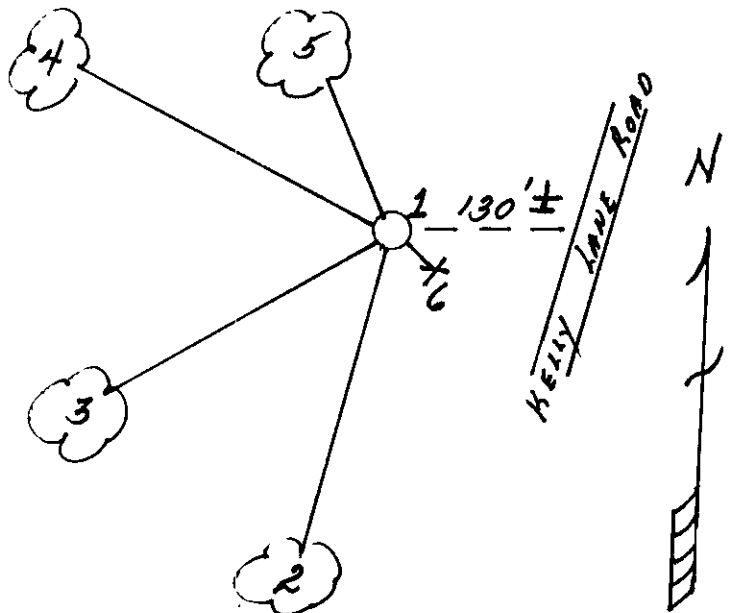

(i) I, Milo E. Stefan

(type or print name) certify that the corner location on this record was determined by me or under my direction and control and that this U.S. Public Land Survey Monument Record is correct and complete to the best of my knowledge and belief.

Milo E. Stefan
Signature

August 2, 1994

Date



Index No. E-3

Stamp 3605060020