U.S. PUBLIC LAND SURVEY MONUMENT RECORD

Note: This form is intended and designed to fulfill all requirements of Wisconsin Administrative Code, Chapter A-E 7.08 U.S. Public Land Survey Monument Record (3) (a) (b) (c) (d) (e) (f) (g) (h) (i). An additional sheet may be added if necessary to conform with said requirements.

(a) Corner location: Township 36 North

Range 5 East/~~West~~

Town/~~City/Village~~ Little Rice

County Oneida

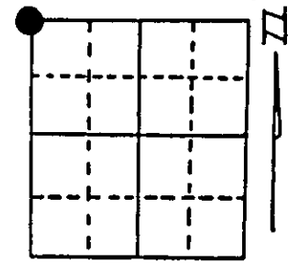

Section 15

(b) (f) (g) (h) Description of monument found at this corner and if it was accepted, state all evidence (material, testimonial, occupational, plats, records, other monuments) used as a basis for accepting. If not accepted or if nothing was found, state evidence used as basis for establishing location. If reestablished through lost corner proportionate methods, indicate all monuments, distances and directions used to establish. Indicate type of monument found or set and sign post.

6/1863 - Joseph Jenkins established this corner at 80.00 chains and set wood post with two BTs:
15" Red Pine, S8°W, 24 Links (15.84') 10" Aspen, S38°E, 18 Links (11.88')

1/30/1935 - A. J. Lytle found evidence of original corner. He rescribed the Red Pine - Aspen gone.

7/28/1994 - Milo E. Stefan found 2" x 60" iron pipe with brass cap stamped to identify corner with "Wis Conservation Dept" across upper edge of brass cap. We made four new BTs: Only Aspen available.

(c) (d) (e) Plan view of corner with ties to at least 4 witness monuments. If in disagreement with previously established corner, show the distances between the two corners and also indicate the ties to the disputed corner.

1) 2" x 60" Iron Pipe/B.C.
2) 5" Aspen, N81°E, 21.21'.
3) 5" Aspen, S12°E, 12.32'.
4) 10" Aspen, S35°W, 74.75'.
5) 4" Aspen, S82°W, 11.40'.
6) Plastic Sign Post, South, 2.1'.

Distances to nail in side of BTs.
Stump blaze scribed "BT".

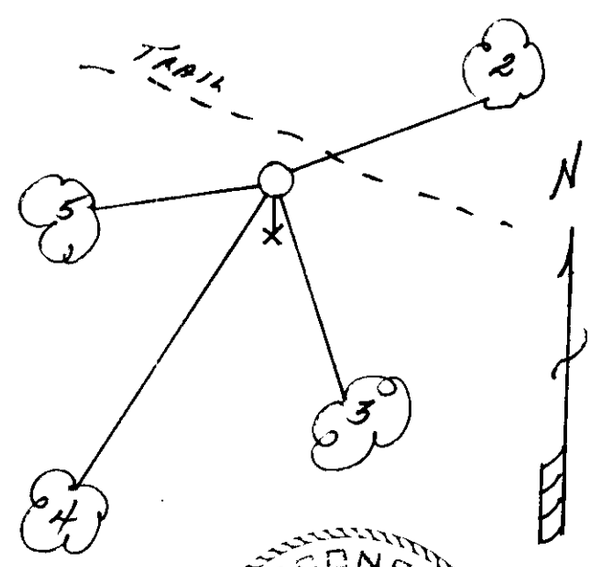

(i) I, Milo E. Stefan (type or print name) certify that the corner location on this record was determined by me or under my direction and control and that this U.S. Public Land Survey Monument Record is correct and complete to the best of my knowledge and belief.

Milo E. Stefan August 2, 1994

Signature Date

WISCONSIN MILO E. STEFAN 5 RHINELANDER, WIS. LAND SURVEYOR

Index No. J-13

Stamp 3605090000