


U.S. PUBLIC LAND SURVEY MONUMENT RECORD

Note: This form is intended and designed to fulfill all requirements of Wisconsin Administrative Code, Chapter A-E 7.08 U.S. Public Land Survey Monument Record (3) (a) (b) (c) (d) (e) (f) (g) (h) (i). An additional sheet may be added if necessary to conform with said requirements.

(a) Corner location: Township 36 North
 Range 5 East/West

Town/City/Village Little Rice

County Oneida

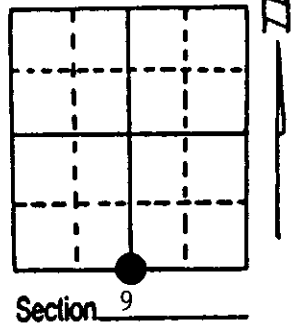


(b) (f) (g) (h) Description of monument found at this corner and if it was accepted, state all evidence (material, testimonial, occupational, plats, records, other monuments) used as a basis for accepting. If not accepted or if nothing was found, state evidence used as basis for establishing location. If reestablished through lost corner proportionate methods, indicate all monuments, distances and directions used to establish. Indicate type of monument found or set and sign post.

- 6/1863 - Joseph H. Jenkins established this corner. He set a wood post with BTs:
 6" Birch, N24°E, 16 Links (10.56') 8" Birch, South, 17 Links (11.22')
- 1/30/1935 - A. J. Lytle restored corner by Lost Methods, placed a wood post and one new BT: 30" White Pine Stump, S14°E, 31½ Links (20.79').
- 4/19/1995 - Milo E. Stefan ran traverse between Section Corners East and West and found distance to be 5241.80'. Lytle's 5237.10'. We restored corner by Lost Methods. Found stump hole and several scattered parts of large parts of White Pine Stump, S5°E, 21'. This is remains of Lytles BT.

(c) (d) (e) Plan view of corner with ties to at least 4 witness monuments. If in disagreement with previously established corner, show the distances between the two corners and also indicate the ties to the disputed corner.

- 1) 2" x 30" Aluminum Monument
- 2) 8" Red Oak, North, 58.08'
- 3) 12" Red Oak, S73°E, 26.75'
- 4) 10" Red Oak, (Twin), S40°W, 31.64'
- 5) 10" Red Oak, N56°W, 5.57'
- 6) Plastic Sign Post, Northeast, 1.0'

Distances to nail in side of BTs.
 Stump blaze scribed "BT".
 Bearing tree posters placed on each BT.

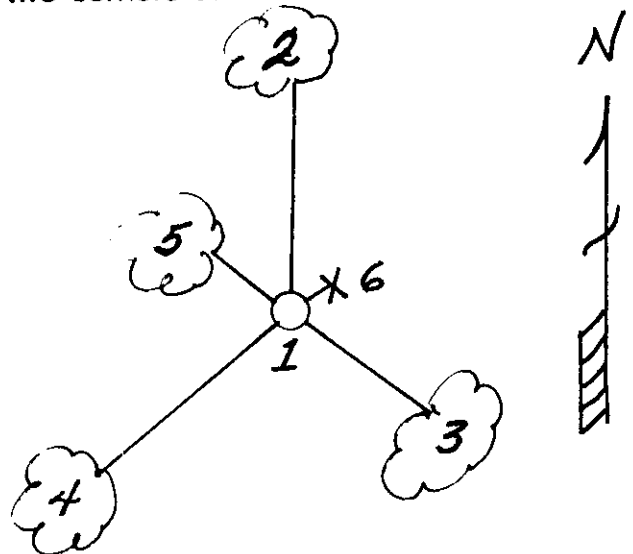

REGISTER OF DEEDS OFFICE
 ONEIDA COUNTY WIS
FILED
 MAY 23 1995
 At _____ O'Clock _____ M
THOMAS H. LEIGHTON
 REGISTER OF DEEDS

WISCONSIN
 MILO E. STEFAN
 1558
 RAINLANDER
 WIS.
 LAND SURVEYOR

(i) I, Milo E. Stefan
 (type or print name) certify that the corner location on this record was determined by me or under my direction and control and that this U.S. Public Land Survey Monument Record is correct and complete to the best of my knowledge and belief.

Milo E. Stefan
 Signature

May 8, 1995
 Date

Index No. J-11

3605090020