U.S. PUBLIC LAND SURVEY MONUMENT RECORD

Note: This form is intended and designed to fulfill all requirements of Wisconsin Administrative Code, Chapter A-E 5.02, U.S. Public Land Survey Monument Record (3) (a) (b) (c) (d) (e) (f) (g) (h) (i). An additional sheet may be added if necessary to conform with said requirements.

(a) Corner location: Township 36 North

Range 5 East/[redacted]

Town/[redacted] Little Rice

County Oneida

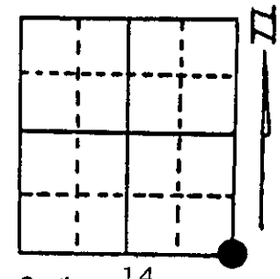

Section 14

(b) (f) (g) (h) Description of monument found at this corner and if it was accepted, state all evidence (material, testimonial, occupational, plats, records, other monuments) used as a basis for accepting. If not accepted or if nothing was found, state evidence used as basis for establishing location. If reestablished through lost corner proportionate methods, indicate all monuments, distances and directions used to establish.

-1863 Jenkins North between 23-24 80 ch. set Post B. Pine 8" N 60 W 61 lks.
B. Pine 7" N 8 E 49 lks.
-1906 Vaughan at corner stp. S 52 W.41 ch., org. N 63½ W .61 ch.
-1934 Ray Hall at corner New B.T.'s J. Pine 8" S 9.75 W 1.04 ch.
J. Pine 3" N 40 W 59 lks.
-1983 Bill Stuth found corner 1½" I.P.
-1989 Replaced 1½" I.P. with capped Re-Bar 5' long witnessed as shown below.

(c) (d) (e) Plan view of corner with ties to at least 4 witness monuments. If in disagreement with previously established corner, show the distances between the two corners and also indicate the ties to the disputed corner.

NOTE:

MEASUREMENTS TAKEN FROM 6" SPIKE IN SIDE OF TREE

BEARINGS TAKEN WITH HANDHELD MAGNETIC COMPASS

NO SCALE

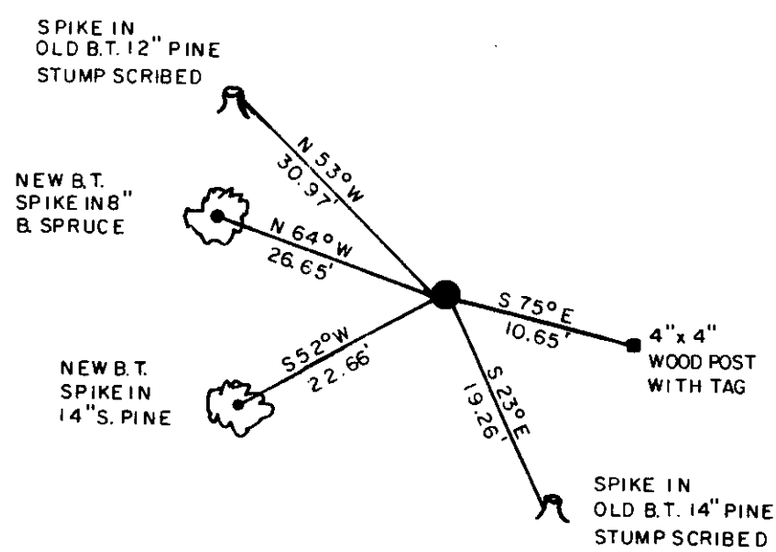

REGISTER OF DEEDS OFFICE
ONEIDA COUNTY, WIS
FILED
FEB 7 1991
At ____ O'Clock ____ M
THOMAS H. LEIGHTON
REGISTER OF DEEDS

(i) I, William E. Bandow (type or print name) certify that the corner location on this record was determined by me or under my direction and control and that this U.S. Public Land Survey Monument Record is correct and complete to the best of my knowledge and belief.

William E. Bandow 2-1-91

Signature Date

WISCONSIN
WILLIAM E. BANDOW
S-1182
RHINELANDER
WIS.
LAND SURVEYOR

Index No. N-21

3605140000