


U.S. PUBLIC LAND SURVEY MONUMENT RECORD

Note: This form is intended and designed to fulfill all requirements of Wisconsin Administrative Code, Chapter A-E 5.02, U.S. Public Land Survey Monument Record (3) (a) (b) (c) (d) (e) (f) (g) (h) (i). An additional sheet may be added if necessary to conform with said requirements.

(a) Corner location: Township 36 North
 Range 5 East/West

Town/Village Little Rice

County Oneida

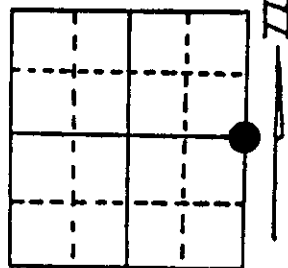

Section 14

(b) (f) (g) (h) Description of monument found at this corner and if it was accepted, state all evidence (material, testimonial, occupational, plats, records, other monuments) used as a basis for accepting. If not accepted or if nothing was found, state evidence used as basis for establishing location. If reestablished through lost corner proportionate methods, indicate all monuments, distances and directions used to establish.

- 1863 Jenkins North between 13-14 40 ch. set Post B. Pine 8" N 82 W 300 lks.
 B. Pine 8" N 11 E 280 lks.
- 1983 Bill Stuth at corner.
- 1987 William E. Bandow found I.P. and replaced it with an Oneida County Monument witnessed as shown below W. Post W 1.00'


(c) (d) (e) Plan view of corner with ties to at least 4 witness monuments. If in disagreement with previously established corner, show the distances between the two corners and also indicate the ties to the disputed corner.

NOTE:

MEASUREMENTS TAKEN FROM
 6" SPIKE IN SIDE OF TREE

BEARINGS TAKEN WITH
 HANDHELD MAGNETIC
 COMPASS

NO SCALE

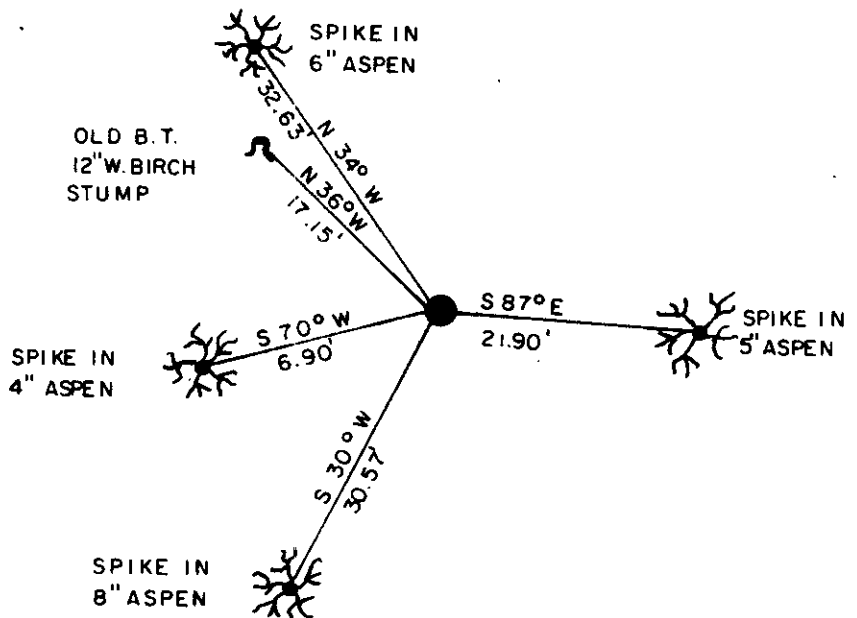

REGISTER OF DEEDS OFFICE
 ONEIDA COUNTY, WIS.
FILED
 FEB 7 1991
 At _____ O'Clock _____ M
THOMAS H. LEIGHTON
 REGISTER OF DEEDS

(i) I, William E. Bandow
 (type or print name) certify that the corner location on this record was determined by me or under my direction and control and that this U.S. Public Land Survey Monument Record is correct and complete to the best of my knowledge and belief.

William E. Bandow 2-1-91
 Signature Date



Index No. L-21