


U.S. PUBLIC LAND SURVEY MONUMENT RECORD

Note: This form is intended and designed to fulfill all requirements of Wisconsin Administrative Code, Chapter A-E 7.08 U.S. Public Land Survey Monument Record (3) (a) (b) (c) (d) (e) (f) (g) (h) (i). An additional sheet may be added if necessary to conform with said requirements.

(a) **Corner location:** Township 36 North
 Range 5 East/West
 Town/City/Village Little Rice
 County Oneida

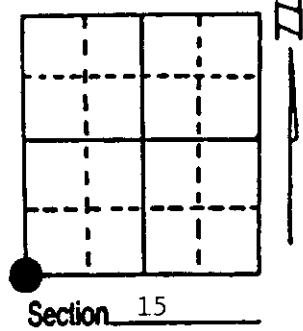


(b) (f) (g) (h) **Description of monument found at this corner and if it was accepted, state all evidence (material, testimonial, occupational, plats, records, other monuments) used as a basis for accepting. If not accepted or if nothing was found, state evidence used as basis for establishing location. If reestablished through lost corner proportionate methods, indicate all monuments, distances and directions used to establish. Indicate type of monument found or set and sign post.**

- 6/1863 - Joseph H. Jenkins established this corner. He set a wood post with BTs:
 5" Tamarack, N38°W, 4 Links (2.64') 5" Spruce, N65°E, 34 Links (22.44')
- 2/1935 - A. J. Lytle found stumps of original BTs. He made a new BT:
 6" Spruce, N34°E, 133 Links (87.78')
 His measured distance North was 73.17 chains (4829.22') and East was 79.38 chains (5239.08').
- 5/3/1995 - Milo E. Stefan found 2" x 60" iron pipe with brass cap. Could have been set by Lytle. We found distance North to be 4831.08' and East 5237.90'.

(c) (d) (e) **Plan view of corner with ties to at least 4 witness monuments. If in disagreement with previously established corner, show the distances between the two corners and also indicate the ties to the disputed corner.**


- 1) 2" x 60" Iron Pipe with Brass Cap.
- 2) 4" Tamarack, N24°E, 31.62'.
- 3) 3" Black Spruce, N86°E, 13.08'.
- 4) 6" Tamarack, S7°E, 35.49'.
- 5) 3" Tamarack, S86°W, 30.87'.
- 6) Plastic Sign Post, South, .65'.

Distances to nail in side of BTs.
 Stumps blaze scribed "BT".
 Bearing tree poster placed on each BT.

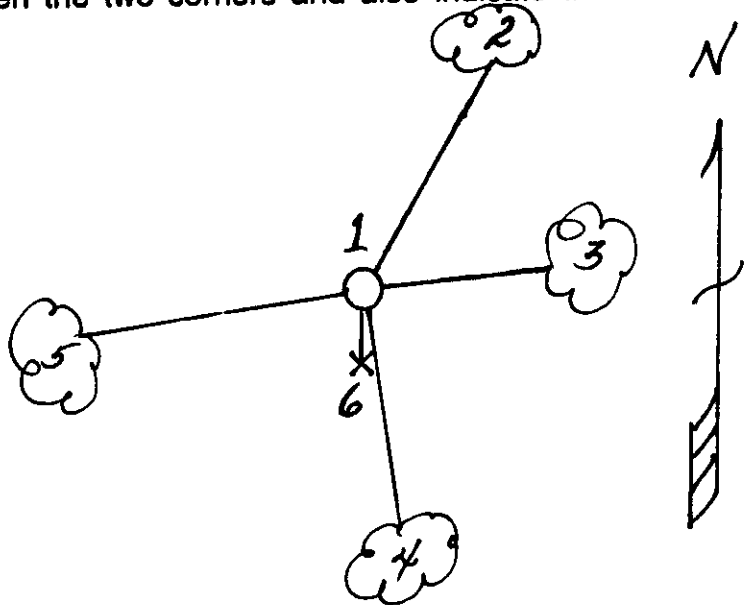

REGISTER OF DEEDS OFFICE
 ONEIDA COUNTY, WIS
FILED
 MAY 23 1995
 At _____ O'Clock _____ M
THOMAS H. LEIGHTON
 REGISTER OF DEEDS

(i) I, Milo E. Stefan
 (type or print name) certify that the corner location on this record was determined by me or under my direction and control and that this U.S. Public Land Survey Monument Record is correct and complete to the best of my knowledge and belief.

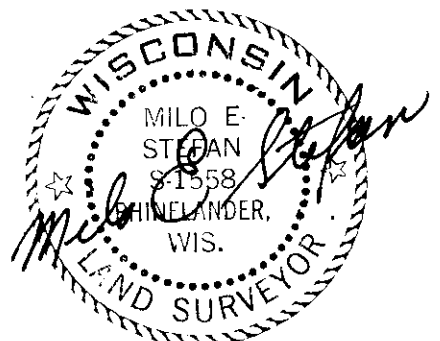

Milo E. Stefan Date May 8, 1995
 Signature Date

Index No. N-13