

CERTIFIED LAND CORNER RESTORATION

Index No. 8-1

State of Wisconsin } ss.
County of Oneida }


History of original corner establishment:
No evidence of any previous corner.

I Glen Barker, do hereby
certify that on the 8th day
of December, 1983, I found Estab.
~~renewed~~ of the N 1/16
corner of Sections 25 & 30
Township 36, North, Range
5 & 6 East, Fourth Principal Meridian.

I established a new monument and accessories
as described hereon; and that from this evidence
I established hereon to perpetuate the original
location of this corner.

Resident witnesses:

J. Clafin - RLS
H. Wagoner

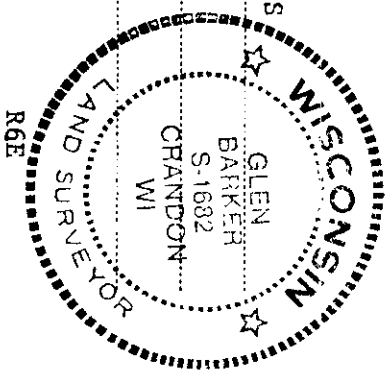


Description of corner evidence found:

Total distance from section corner 24-25/19-30, T36N R5&6E to 1/4 corner
between sections 25 & 30 is 2629.59'.
Set N1/16 1314.80'.

Description of monument and accessories I established to perpetuate the original location of this corner.
Set a 1" iron pipe with 2" diameter alloy cap stamped:

Monument projects 18" above ground. S1682
Marked NBTs: R 5E T36N R6E
Black spruce 6" N72E 20.70'
Tamarack 6" S41W 26.11' N 1/16 25 30
Scribed 1/16 - B.T. CPI - 1983

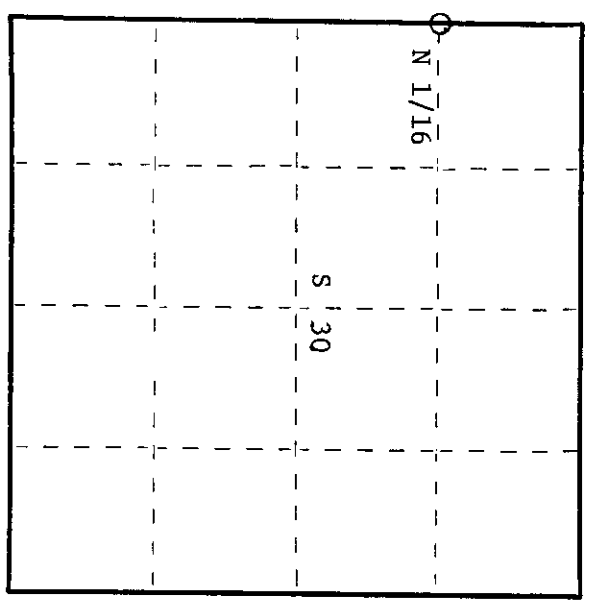

○ = Corner monument restored.

Dated at Rhineland, Wis., this 13th day of February, 19 84

Signature Glen Barker Title Registered Land Surveyor Registration No. S1682
(County Surveyor, Registered Land Surveyor, or other duly authorized official)
Office of Register of Deeds, County of Oneida, I hereby certify that the within
instrument was filed in this office for record on the 23rd day of February, 1984
at 11:00 o'clock A. M.

Tomie Savage Kuehn
(Register of Deeds)

By: _____ Deputy

3605253000