

U.S. PUBLIC LAND SURVEY MONUMENT RECORD

Note: This form is intended and designed to fulfill all requirements of Wisconsin Administrative Code, Chapter A-E 7.08 U.S. Public Land Survey Monument Record (3) (a) (b) (c) (d) (e) (f) (g) (h) (i). An additional sheet may be added if necessary to conform with said requirements.


(a) Corner location: Township 36 North

Range 5 East


Town _____ of Little Rice

County of Oneida

REGISTER OF DEEDS OFFICE
ONEIDA COUNTY WIS.

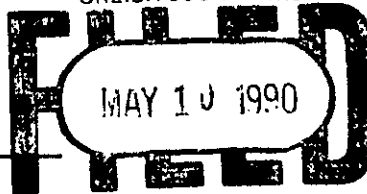

At _____ O'Clock _____ M
THOMAS H. LEIGHTON
REGISTER OF DEEDS

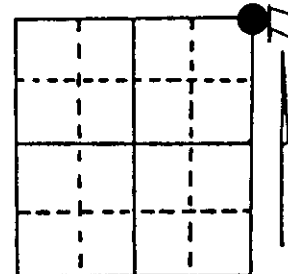


Section 32

(b) (f) (g) (h) Description of monument found at this corner and if it was accepted, state all evidence (material, testimonial, occupational, plats, records, other monuments) used as a basis for accepting. If not accepted or if nothing was found, state evidence used as basis for establishing location. If reestablished through lost corner proportionate methods, indicate all monuments, distances and directions used to establish. Indicate type of monument found or set and sign post.

June 1863, Orig. cor. estab. by Joseph H. Jenkins North between 32 & 33....
80.00 set post for cor. to Sections 28, 29, 32 & 33, B.T.s Cedar 8 N 30 E 14;
Cedar 14 S 52 E 26

April 1989, I found a post point in wet cedar swamp. No evidence of Orig.
B.T.s I set a 2" x 30" Oneida County Capped Monument for the corner to
replace the post point and witnessed it as shown below.

(c) (d) (e) Plan view of corner with ties to at least 4 witness monuments. If in disagreement with previously established corner, show the distances between the two corners and also indicate the ties to the disputed corner.

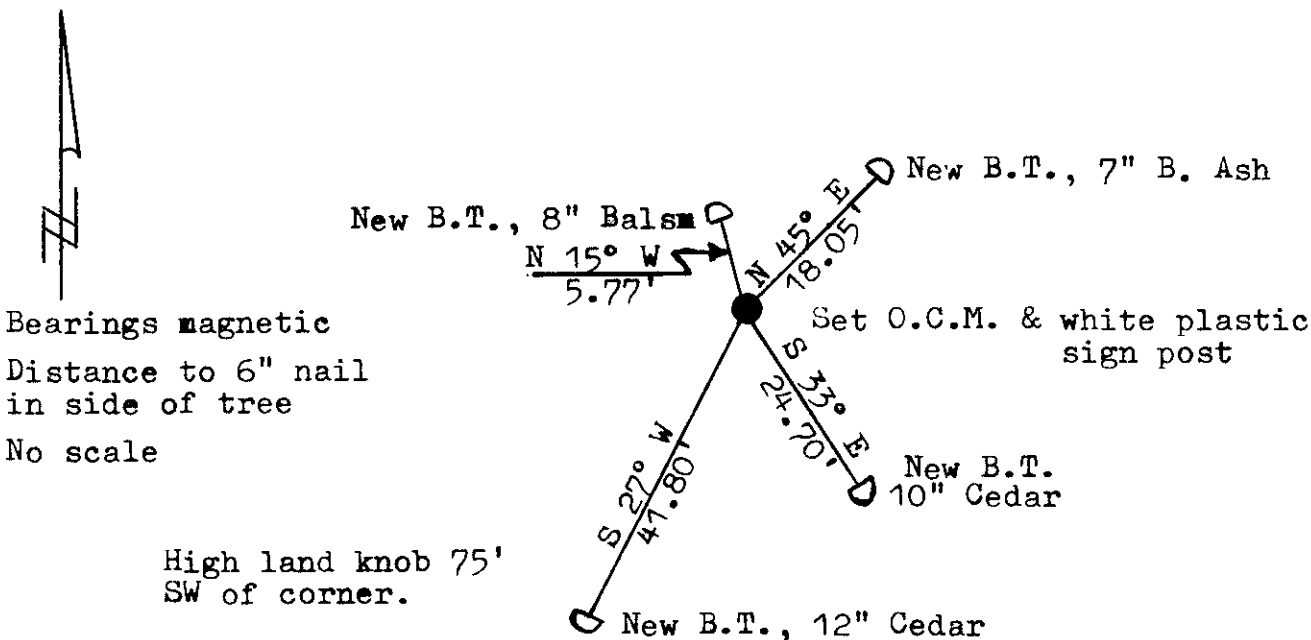

(i) I, Lester J. Schmit R.L.S. 1192
(type or print name) certify that the corner location on this record
was determined by me or under my direction and control and that
this U.S. Public Land Survey Monument Record is correct and
complete to the best of my knowledge and belief.

Lester J. Schmit
Signature

3 May 1990
Date



3605290000


Index No. V-1-9

U.S. PUBLIC LAND SURVEY MONUMENT RECORD

Note: This form is intended and designed to fulfill all requirements of Wisconsin Administrative Code, Chapter A-E 7.08 U.S. Public Land Survey Monument Record (3)(a-i).

(a) CORNER LOCATION
 Cor. of Secs. 28, 29, 32 & 33
 Township 36 North
 Range 5 East of the 4th P.M.
 Town of Little Rice
 County of Oneida

WISCRS - Oneida County
 N: 140,018.11 USft
 E: 144,375.84 USft
 Datum: NAD 83(2011) ep. 2010.00
 GNSS Method: RTN - Direct
 GNSS Control: WISCORS VRS

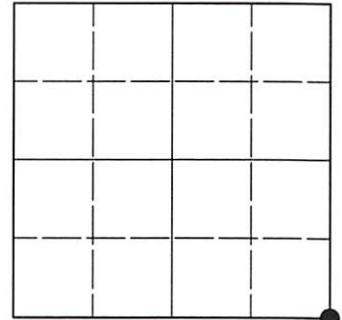

Sec. 29, T. 36 N., R. 5 E.

(b)(f)(g)(h) Description of monument found at this corner and if it was accepted, state all evidence (material, testimonial, occupational, plats, records, other monuments) used as a basis for accepting. If not accepted or if nothing was found, state evidence used as basis for establishing location. If re-established through lost corner proportionate methods, indicate all monuments, distances and directions used to establish. Indicate type of monument and sign post found or set.

This record is a perpetuation of the following land corner document(s):


May 3, 1990: USPLS Monument Record by Lester J. Schmit, filed in Oneida County

A complete history of the corner can be found on the previous land corner document(s). I accept the record activity as a true and faithful perpetuation or reestablishment of the original corner location and further perpetuate it as described below.

July 14, 2022: I found and accepted the record monument, a 2.4" diam. aluminum pipe, loosely set, with a 3.3" diam. Oneida Co. aluminum cap projecting 3" above the bog surface. The record balsam bearing tree is standing dead. The record 10" cedar bearing tree is down. I found or established accessories as indicated below. I found a white vinyl sign post bearing Southwest, 1.4 ft.

The coordinate value shown is the weighted mean of two or more GNSS observations at markedly different times satisfying the accuracy requirements defined and qualified in the 2022 Oneida County Fee Schedule for USPLS Corners.

(c)(d)(e) Plan view of corner with ties to at least 4 witness monuments. If in disagreement with previously established corner, show the distances between the two corners and also indicate the ties to the disputed.

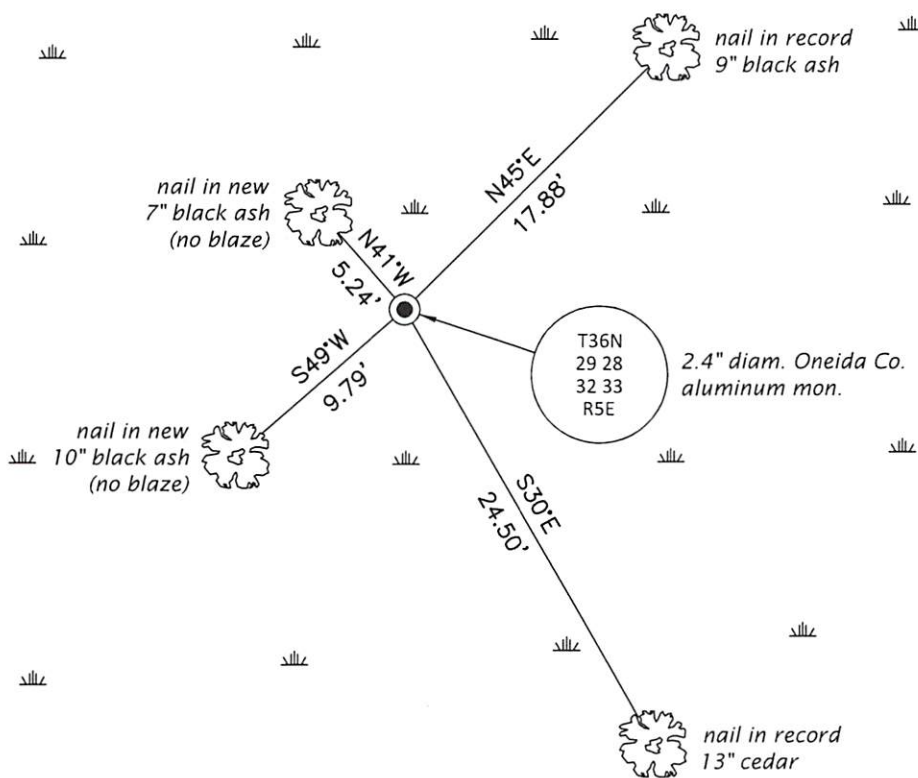

REGISTER OF DEEDS OFFICE
 ONEIDA COUNTY
 FILED

AUG 31 2022

KYLE J. FRANSON
 REGISTER OF DEEDS

(i) I, Jeffrey W. Austin, Professional Land Surveyor No. S-1885, hereby certify that the corner location on this record was determined by me or under my direction and control and that this U.S. Public Land Survey Monument Record is correct and complete to the best of my knowledge and belief.

 Signature

AUG - 1, 2022

 Date