

U.S. Public Land Survey Monument Record

I, Gregory J. Raymond, Professional Land Surveyor #2506, do hereby certify that on the 30th day of September, 2025, I found no evidence of the quarter corner common to Sections 4-3, Township 36 North, Range 6 West of the fourth principal meridian, as described hereon.



Description of Corner Evidence Found:

This corner was restored through lost corner proportionate methods.

I, Gregory J. Raymond, Professional Land Surveyor #2506, do hereby certify that the corner location shown on this record was determined by me or under my direction and control and that this U.S. Public Land Survey Monument Record is correct and complete to the best of my knowledge and belief.


Gregory J. Raymond, P.L.S. 2506

10/1/25

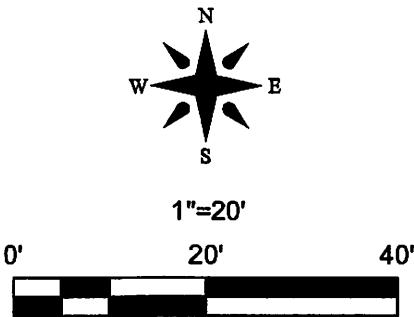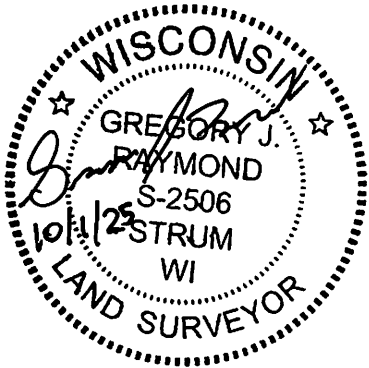


- LEGEND
- ☒ SET PUBLIC LAND SURVEY SYSTEM MONUMENT (1.25" X 18" IRON BAR weighing 4.17 pounds per linear foot.)
 - SET 1" OUTSIDE DIAMETER X 18" IRON PIPE, 1.13 POUNDS PER LINEAR FOOT


Recreational Trail

County Coordinates
Northing (Y): 164019.07
Easting (X): 181242.32

Datum: NAD83(2011)

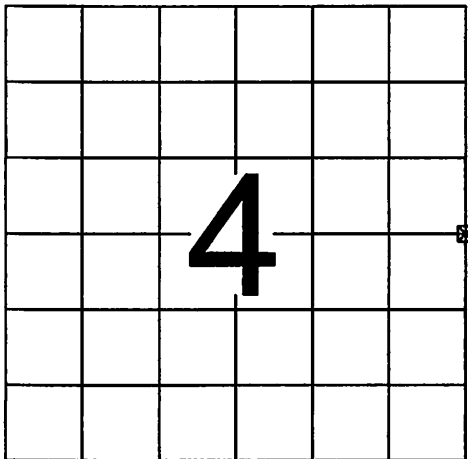

3606042000

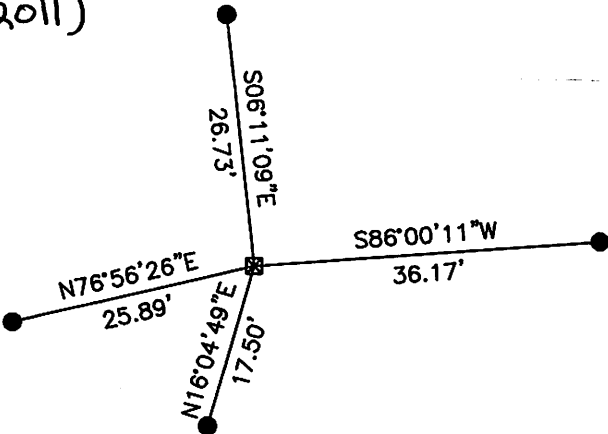

RAYMOND SURVEYING, LLC
W19343 Hwy 10
Strum, WI 54770
www.raymond-surveying.com