U.S. PUBLIC LAND SURVEY MONUMENT RECORD

REGISTER OF DEEDS OFFICE
ONEIDA COUNTY
FILED

JUN 01 2017

AT_____O'CLOCK_____M
KYLE J. FRANSON
REGISTER OF DEEDS

(RECORDING AREA)

Note: This form is intended and designed to fulfill all requirements of the Wisconsin Administrative Code, Chapter A-E 7.08 U.S. Public Land MonumentRecord (3)(a)(b)(c)(d)(e)(f)(g)(h)(i). An additional sheet may be added if necessary to conform with said requirements.

(a) CORNER LOCATION:
Southeast Corner of Section 5
Township 36 North
Range 6 East
Town of Nokomis
County of Oneida

WISCRS - Oneida County
North: 161319.710 USft
East: 175822.875 USft
Latitude: 45° 37' 41.86657" N
Longitude: 89° 45' 22.28843" W
Datum: NAD 83(2011)
GNSS Method: RTK - Direct
GNSS Control: WISCORS VRS
Record North: 161319.755 USft
Record East: 175822.865 USft
Record Datum: NAD 83(1991)

SECTION 5

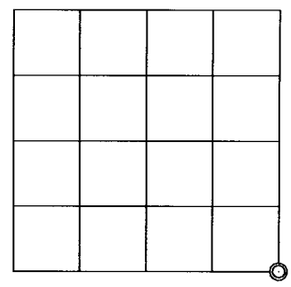

(b) HISTORY OF ORIGINAL CORNER ESTABLISHMENT
Original Surveyor: Joseph H. Jenkins
Date of Survey: Commenced October, 13, 1862
Completed October 28,1862
Original B.T.'S: Tamarack 6" N 28°E, 98 lks.
Tamarack 6" S 15°E 123 lks.

(f)(g)(h) DESCRIPTION OF MONUMENT FOUND AT THIS CORNER AND IF IT WAS ACCEPTED, STATE ALL EVIDENCE (MATERIAL, TESTIMONIAL, OCCUPATIONAL, PLATS, RECORD, OTHER MONUMENTS) USED AS A BASIS FOR ESTABLISHING LOCATION. IF NOT ACCEPTED OR IF NOTHING WAS FOUND, STATE EVIDENCE USED AS BASIS FOR ESTABLISHING LOCATION. IF REESTABLISHED THROUGH LOST CORNER PROPORTIONATE METHODS, INDICATE ALL MONUMENTS, DISTANCES AND DIRECTIONS USED TO ESTABLISH. INDICATE TYPE OF MONUMENT AND SIGN POST FOUND OR SET.

October 28, 1949 - Ivan Branham, surveyor, (Branham Field Book 7, pages 57 and 58) resurvey of line between Sections 4 and 9, "Start from known Cor. Secs. 4-5-8-9".

1963 - Owens-Illinois (Ownership Boundary Survey, map drawn by W. H. Stuth, filed in NEPCO Book 1, pages 37 and 38) for a survey in Section 9, T36N, R6E, legends this corner "BY OTHERS".

March 27th, 2017 - James D. Rein, PLS No. 1234, we recovered a 1 1/2" dia. with a 1 3/4" nut on top flush in wetland bog, referenced by a guard post 0.7' east. Although we find no remaining original evidence of the corner, I accept it as the best available evidence of the original corner position. We drove an Oneida County capped 2.4" dia. x 30" long aluminum monument over the iron pipe and made new reference ties as shown in the plan.

The coordinate value shown has been verified by at least one of the following methods: 1) comparison to a previously GPS determined published value; 2) the value is the average of two or more GPS observations at a markedly different time; 3) one or more distances were measured back to the GPS observed corner from temporary GPS observed offset locations.

(c)(d)(e) PLAN VIEW OF CORNER WITH TIES TO AT LEAST 4 WITNESS MONUMENTS. IF IN DISAGREEMENT WITH PREVIOUSLY ESTABLISHED CORNER, SHOW THE DISTANCE BETWEEN THE TWO CORNERS AND ALSO INDICATE THE TIES TO THE DISPUTED CORNER.

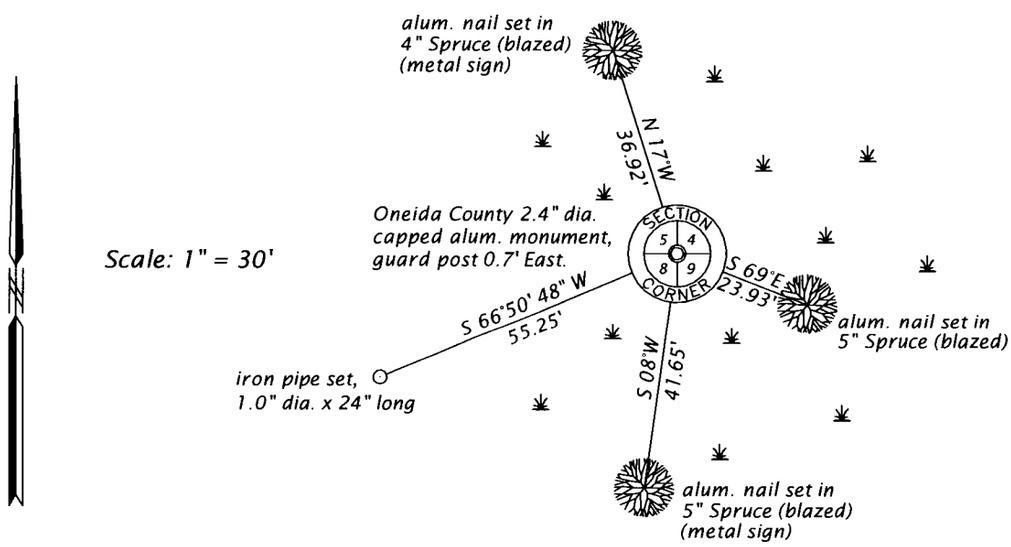

(i) I, JAMES D. REIN, PROFESSIONAL LAND SURVEYOR NO. S-1234 HEREBY CERTIFY THAT THE CORNER LOCATION ON THIS RECORD WAS DETERMINED BY ME OR UNDER MY DIRECTION AND CONTROL AND THAT THIS U.S. PUBLIC LAND SURVEY MONUMENT RECORD IS CORRECT AND COMPLETE TO THE BEST OF MY KNOWLEDGE AND BELIEF.

WISCONSIN
JAMES D.
REIN
S-1234
MINOCQUA,
WI
LAND SURVEYOR

5-24-17

SIGNATURE DATE

INDEX NO. E - 9
3606050000