

At \_\_\_\_\_ O'Clock \_\_\_\_\_ M  
**THOMAS H. LEIGHTON**

REGISTER OF DEEDS

This form is intended to fulfill the requirements of Chapter A-E7.08 (3)(a) thru (i) U.S. Public Land Survey Monument Location Record, Wisconsin Administrative Code. Use the reverse side of form for continuation.

**U.S. PUBLIC LAND SURVEY MONUMENT LOCATION RECORD**

Recorders Data

USPLS CORNER: NW SECTION: 16 TOWNSHIP: 36 NORTH RANGE: 6 EAST  
 NAME OF WATERWAY FOR M.C. CORNER: N/A SECTION LINE: N/A  
 (CITY)(VILLAGE)(TOWN) OF: NOKOMIS COUNTY OF: ONEIDA

Description of monument found or placed and all other evidence used as the basis for monument location; including monuments and measurements required if the corner location was reestablished by lost corner proportionate methods. Also indicate name of the original surveyor, original survey date and the corner monument, bearing trees, witness or other reference monuments established, including measured bearing and distance ties, from available survey records.

In October 1862, Joseph H. Jenkins/GLO set a wood post as original corner in a marsh and noted OBTs: a 10" Pj S33°E 426 links and a 9" Pj N59°W 365 links; all are now obliterated.


In June 1906, D.H. Vaughan found post set by George Smith at this corner in swamp and the stumps of original GLO survey Pj bearing trees SE & NW per Page 64 of Vaughan Book 5 field notes in Oneida County survey records.

In July 2002, Aero-Metric, Inc. found a 2" dia. iron pipe at this corner during a GPS location survey at 89.757150° West Longitude and 45.613744 North Latitude per Oneida County survey records.

On October 5, 2006 I found a very old 1.5" dia. iron pipe with plain coupling at top 12" above keg marsh surface, an old 4.5" dia. x 44" high squared & scribed top wood marker post 6" North and a leaning standard white poly "T" marker post 1' East. I pulled the old 33" long iron pipe and drove a standard 2" dia. x 30" long aluminum pipe monument with stamped Oneida County cap into the plumb soil cavity left by the old iron pipe to 2" up. I left the old iron pipe flat on grade nearby and reset the standard "T" post vertical.

Corner falls about 65' South of edge of woods along north side of the marsh and is accessible by walk-in about 600' West of an unimproved woods road running westerly and southerly from Prairie Lake Road; there were no direct witnesses.

Plan view map of monument location with bearing and distance ties to a minimum of four(4) described witness or reference monuments of concrete, natural stone, iron, live bearing trees or equivalent material. If applicable, also show a minimum of two(2) bearing and distance ties to any other monument found and not accepted; including the bearing and distance from the accepted monument.

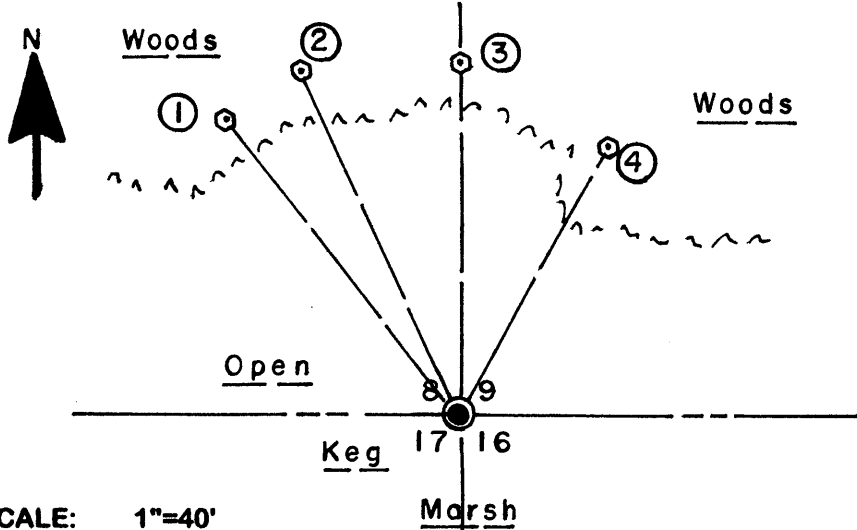

**WITNESS MONUMENT TIES:**

- ① New 7" Or BT N38°W 79.20'.
- ② New 8" Pj BT N25°W 79.50'.
- ③ New 7" Or BT with double trunk 12" above grade North 73.55'.
- ④ New 8" Pj BT N29°E 64.50'.

I flagged BTs, posts and new monument blaze orange.

SCALE: 1"=40'

Unless otherwise indicated, all bearing tree ties are to a .25" dia. by 2.5" long PK nail with a 1.25" dia. steel washer driven into unblazed right face and a .25" dia. by 2.5" long PK nail with a 2" dia. steel washer stamped BT is also driven into unblazed face of bearing tree at DBH; the basis for measured bearings is by compass to nearest degree and all tie distances are measured horizontal by steel tape corrected to nearest 1/100th feet at standard temperature of 68° F.


RLS SEAL:



LAND SURVEYOR CERTIFICATE:

I, William C. Rohde, hereby certify that I am duly licensed as a Professional Land Surveyor in the State of Wisconsin; that this USPLS monument location was determined by me and/or under my direct supervision and control; and that this U.S. Public Land Survey Monument Location Record is true and correct to the best of my knowledge and belief.

Signed *William C. Rohde*  
William C. Rohde RLS 841

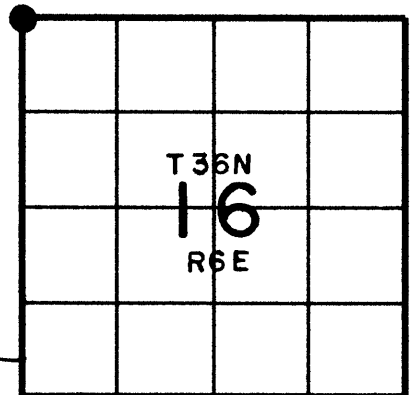

SECTION LOCATION MAP

INDEX NO. J 9  
3606080000