

# U.S. PUBLIC LAND SURVEY MONUMENT RECORD

Note: This form is intended and designed to fulfill all requirements of Wisconsin Administrative Code, Chapter A-E 7.08 U.S. Public Land Survey Monument Record (3) (a) (b) (c) (d) (e) (f) (g) (h) (i). An additional sheet may be added if necessary to conform with said requirements.


(a) Corner location: Township 36 North

Range 6 East

Town                      of Nokomis

County            of Oneida

REGISTER OF DEEDS OFFICE  
ONEIDA COUNTY, WIS.  
**FILED**  
MAY 23 1991  
At            O'Clock            M  
**THOMAS H. LEIGHTON**  
REGISTER OF DEEDS

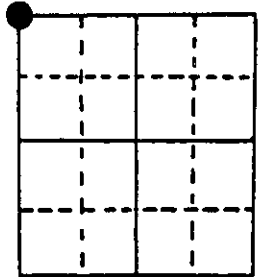

Section 15


(b) (f) (g) (h) Description of monument found at this corner and if it was accepted, state all evidence (material, testimonial, occupational, plats, records, other monuments) used as a basis for accepting. If not accepted or if nothing was found, state evidence used as basis for establishing location. If reestablished through lost corner proportionate methods, indicate all monuments, distances and directions used to establish. Indicate type of monument found or set and sign post.

Oct. 1862, Orig. cor. estab. by Joseph H. Jenkins North between 15 & 16....  
80.00 set post corner to Sections 9, 10, 15 & 16, B.T.s Blk Pin 8 N 57 E 28,  
Y. Pine 30 S 38 E 63, Y. Pine 34 S 61 W 24 & Blk Pine 7 N 34 W 86.

1901 D.H. Vaughan found w. tree is a stub 60' high, e. one is down, found stump of the others, set post & made new bearings, B.Pine 8 N 36 1/2 W 36 & B.Pine 8 S 62 E 26.

1991 I found a 3/4" iron pipe inside a 1 1/4" iron pipe for cor. with 4" sq. wood post 0.5' north. The 34" Y.Pine S 61W 24 links is now a rotting stump & fits with call to cor. I set a 2" x 30" Oneida County Capped Monument to replace the iron pipe for the corner, during which time I found a post point from corner rotted off at ground level. I witnessed the O.C.M. as shown below.

(c) (d) (e) Plan view of corner with ties to at least 4 witness monuments. If in disagreement with previously established corner, show the distances between the two corners and also indicate the ties to the disputed corner.

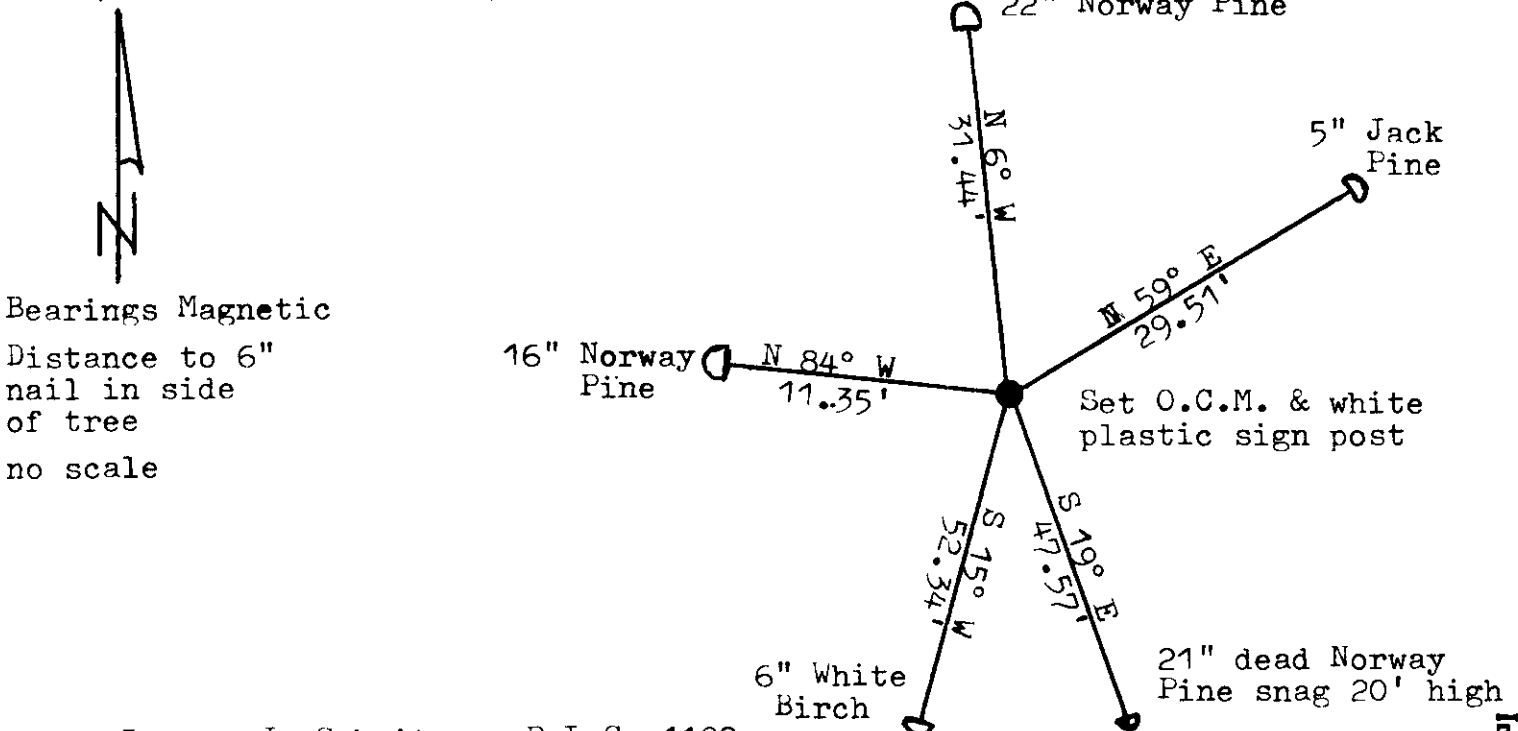

Bearings Magnetic  
Distance to 6" nail in side of tree  
no scale

(i) I, Lester J. Schmit R.L.S. 1192  
(type or print name) certify that the corner location on this record was determined by me or under my direction and control and that this U.S. Public Land Survey Monument Record is correct and complete to the best of my knowledge and belief.

Lester J. Schmit  
Signature

6 May 1991  
Date



Index No. J-13

3606090000