

# U.S. PUBLIC LAND SURVEY MONUMENT LOCATION RECORD

Recorders Data

CORNER: West 1/4 SECTION: 13 TOWNSHIP 36 NORTH RANGE C EAST/WEST

FOR M.C. CORNER INDICATE: NAME OF WATERWAY N/A SECTION LINE N/A

~~(CITY)(VILLAGE)(TOWN)~~ OF: Nokomis COUNTY OF: Oneida

Description of monument found or placed and all other evidence used as a basis for monument location; including all monuments and related measurements required if the corner location is reestablished by lost corner proportionate methods. Also indicate name of original surveyor, survey date, corner monument set and established bearing trees, witness or reference monuments with ties from available records.


Found and accepted an old 1 1/2" dia. iron pipe monument with uncapped top 16" above grade in the center of a cairn of rocks at this corner location. I plumbed and drove the old iron pipe deeper to secure and then set a standard 2" dia. by 30" long aluminum pipe monument with stamped Oneida County cap over it to about 6" above the top of rock cairn. Corner is located about 375' South of an old woods road intersection and 16' East of the centerline of an old unimproved W/S woods roadway.

In 1862, Jenkins/GLO set a wood post at the 1/4 corner and marked OBTs, a 16" Py N17°W 84 lks and a 15" Aspen N68°E 12 lks, all of which are now obliterated. In 1978, Wis DOT noted a 1 1/2" iron pipe at this corner per Plat of Survey No. A-410, Oneida County survey records. A map by W. Stuth in 1987, Oneida County records, of a 1957 Owens-Illinois survey of the East 1/2 of Section 14 west of this corner, indicates an undescribed monument at this corner "by others" and BTs, a 12" Maple S80°W 12.0', now gone, a 10" Maple S20°E 7.0', now gone, a 7" Oak S78°E 23.0', see Witness No. 2 below, and a 12" Oak N35°W 16.0' now gone.

No other corner evidence observed or detected with metal locator within 1/2 chain of corner location area, although flagging was found on a stick in old iron pipe found.

This recovery completed June 15, 1998; there were no witnesses other than I did observe orange flagging tape onto what appears to be a previous survey traverse route along old woods roadways to the North and then West along the North line of Section 14.


Plan view map of monument location with bearing and distance ties to a minimum of four(4) described witness or reference monuments of concrete, natural stone, iron, live bearing trees or equivalent material. If applicable, also show a minimum of two(2) bearing and distance ties to any other monument found and not accepted; including the bearing and distance from the accepted monument. Indicate the basis for bearings of reference ties if not referenced to magnetic north.

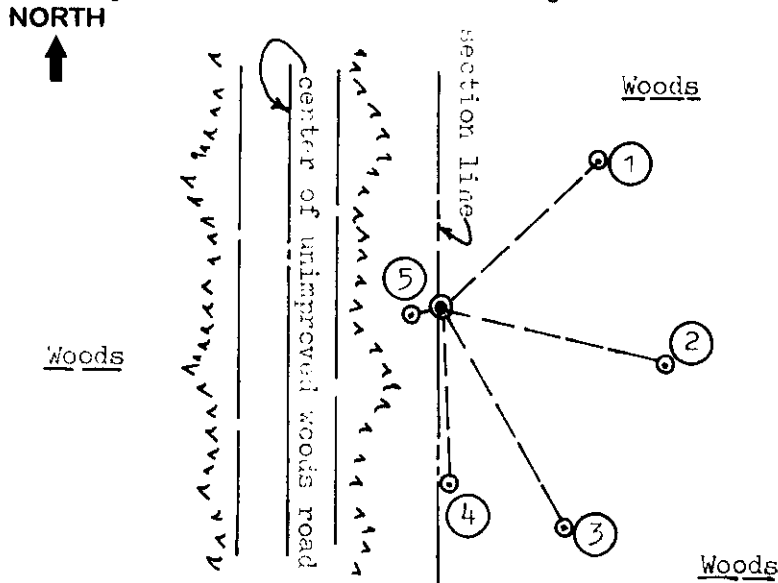

- WITNESS MONUMENT TIES:**
- ① New BT 10' Or N47°E 22.50'.
  - ② New BT 13" Mr S75°E 24.03', that may be 7" Or BT per Owens-Illinois map S78°E 23.0', as ID error.
  - ③ New BT 13" Mr S29°E 26.26'.
  - ④ New BT S02°E 18.80', 9" Mr.
  - ⑤ New BT 7" Bw S81°W 3.00', which is tipped West 15°+/-.
- Note: Standard white poly 'T' marker post set S50°E 1.5' at base of rocks cairn.

SCALE: 1" = 20'

Unless otherwise indicated, all bearing tree ties are to a .25" dia. by 2.5" long PK nail with a 1.25" dia. steel washer driven into unblazed right face and a .25" dia. by 2.5" long PK nail with a 2" dia. steel washer stamped 'BT' is also driven into unblazed face of bearing tree at DBH; the basis for measured bearings is magnetic to nearest degree and all tie distances are horizontal measure to nearest 1/100th feet.

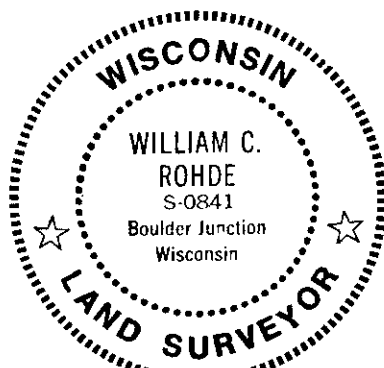

**LAND SURVEYOR CERTIFICATION:**

I, William C. Rohde, hereby certify that I am a duly licensed Professional Land Surveyor in Wisconsin, that this USPLS monument location was determined by me or under my direction and control, and that this U.S. Public Land Survey Monument Location Record is true and correct to the best of my knowledge and belief.

*William C. Rohde* Date: 6-26-98  
Signature

	13		

INDEX NO.

RLS SEAL

SHEET NO. 1 OF 1

This form is intended to fulfill requirements of Chapter A-E 7.08 (3)(a)(b)(c)(d)(e)(f)(g)(h)(i) U.S. Public Land Survey Monument Location Record, Wisconsin Administrative Code. Use reverse side for geodetic location data and/or continuation purposes.

SECTION LOCATION MAP

INDEX NO. L 21  
3606142000