

# U.S. PUBLIC LAND SURVEY MONUMENT RECORD

Note: This form is intended and designed to fulfill all requirements of Wisconsin Administrative Code, Chapter A-E 7.08 U.S. Public Land Survey Monument Record (3) (a) (b) (c) (d) (e) (f) (g) (h) (i). An additional sheet may be added if necessary to conform with said requirements.


(a) Corner location: Township 36 North

Range 6 East

Town                      of Nokomis

County                      of Oneida

REGISTER OF DEEDS OFFICE  
ONEIDA COUNTY, WIS.  
**FILED**  
MAY 23 1991  
At                      O'Clock                      M  
**THOMAS H. LEIGHTON**  
REGISTER OF DEEDS

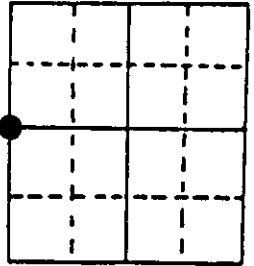

Section 15

(b) (f) (g) (h) Description of monument found at this corner and if it was accepted, state all evidence (material, testimonial, occupational, plats, records, other monuments) used as a basis for accepting. If not accepted or if nothing was found, state evidence used as basis for establishing location. If reestablished through lost corner proportionate methods, indicate all monuments, distances and directions used to establish. Indicate type of monument found or set and sign post.


Oct. 1862, Orig. cor. estab. by Joseph H. Jenkins North between 15 & 16....  
40.00 set 1/4 post for cor. to Sections 15 & 16, B.T.s Blk Pine 7 S 41 E 13 &  
Blk Pine 6 N 78 W 6.

1901 D.H. Vaughan set 1/4 post equidistant between corners, B.T.s Y.Pine stub  
20 N 23 W 241, Y.Pine 20 S 37 E 201 & green Y.Pine N 37 E about 800 dist.

1982 I found a 1 7/8" iron shaft for the corner.

1991 I set a 2" x 30" Oneida County Capped Monument to replace the iron shaft  
for the corner and witnessed it as shown below.

(c) (d) (e) Plan view of corner with ties to at least 4 witness monuments. If in disagreement with previously established corner, show the distances between the two corners and also indicate the ties to the disputed corner.

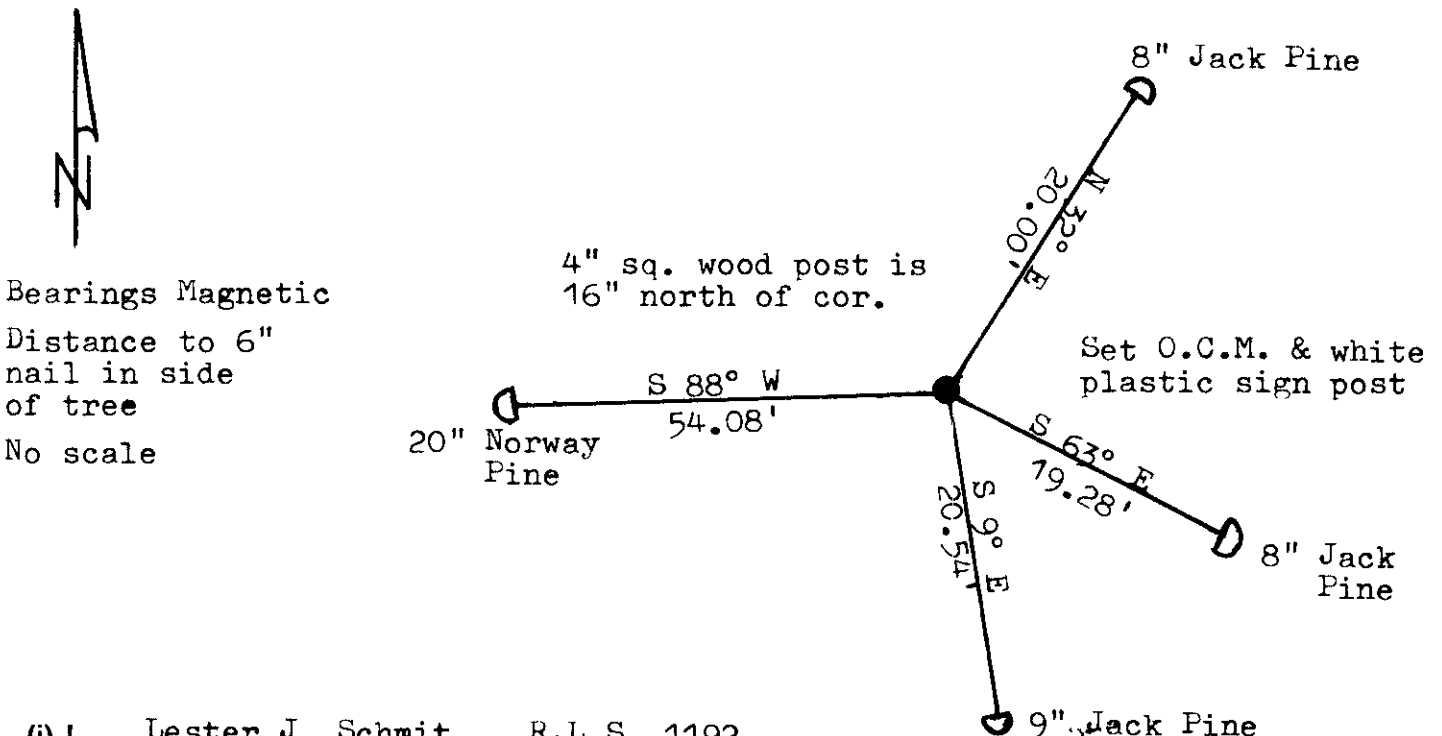

(i) I, Lester J. Schmit R.L.S. 1192  
(type or print name) certify that the corner location on this record  
was determined by me or under my direction and control and that  
this U.S. Public Land Survey Monument Record is correct and  
complete to the best of my knowledge and belief.

Lester J. Schmit 6 May 1991  
Signature Date



Index No. L-13