

CERTIFIED LAND CORNER RESTORATION

Index No. N-8

State of Wisconsin }
County of Oneida } ss.

I Glen Barker, do hereby certify that on the 3rd day

of May, 1984, I found ~~established~~ restored the M.C. West Side Prairie Lake corner of Sections 17 & 20

Township 36 North, Range



6 East, Fourth Principal Meridian,

as described hereon; and that from this evidence I established a new monument and accessories as described hereon to perpetuate the original location of this corner.

Resident witnesses:

N. Spiess

H. Wagoner

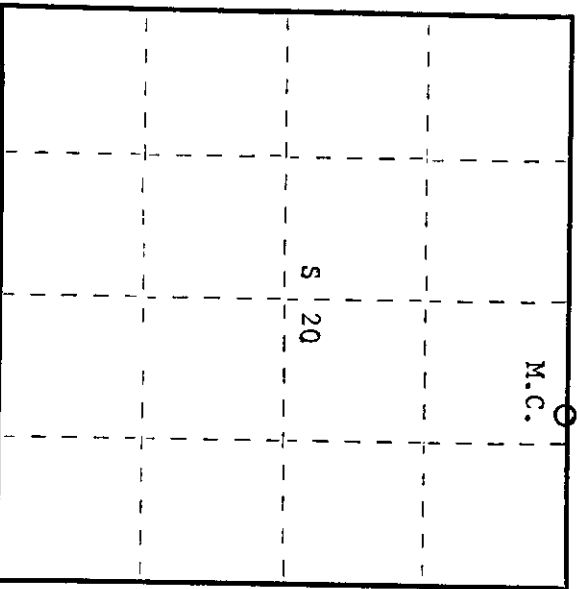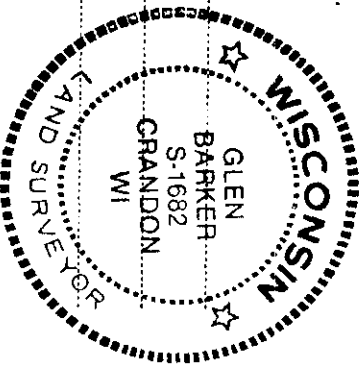

○ = Corner monument restored.

History of original corner establishment:

1" Iron pipe bears No-54-17W of the new established monument.

11/46

Description of corner evidence found:

Ran traverse from Section corner 16-17-20-21 to 1/4 corner between sections 17 & 20 for a distance of 2689.56'.

Set M.C. on line 1158.21' of 1/4 corner and 1531.35' of Section corner.

Description of monument and accessories I established to perpetuate the original location of this corner.
Set a 1" iron pipe 20.0' west of west shore line of Prairie Lake.

Marked NBTs

Triple red oak North 34.03'

Triple Red oak N51W 19.75'

Dated at Rhinelander, Wis., this 17th day of May, 1984.

Signature Glen Barker Title Registered Land Surveyor Registration No. 1682
(County Surveyor, Registered Land Surveyor, or other duly authorized official)

Office of Register of Deeds, County of Oneida
Instrument was filed in this office for record on the 23rd day of May, 1984
at 11:00 o'clock a. M. I hereby certify that the within

Doris Verage Kuehn
(Register of Deeds)

By _____ Deputy