

U.S. PUBLIC LAND SURVEY MONUMENT LOCATION RECORD

Recorders Data

CORNER: North 1/4 SECTION: 20 TOWNSHIP 36 NORTH RANGE 6 EAST/WEST

FOR M.C. CORNER INDICATE: NAME OF WATERWAY N/A SECTION LINE N/A

(CITY)(VILLAGE)(TOWN) OF: Nokomis COUNTY OF: Oneida

Description of monument found or placed and all other evidence used as a basis for monument location; including all monuments and related measurements required if the corner location is reestablished by lost corner proportionate methods. Also indicate name of original surveyor, survey date, corner monument set and established bearing trees, witness or reference monuments with ties from available records.

Found and accepted an old railroad spike driven flush in existing blacktop pavement at this corner location, which falls about 10" East of pavement centerline; no other metal evidence detected with magnetic locator within nearby roadway area.

In 1951, Kirby/Genisot Engineering indicates a monument symbol with note "in place" at this corner, per Plat of Survey B-660, Oneida County records.

In 1977, Schmit/Timberland Surveyors indicates an undescribed monument symbol at this corner, per Plat of Survey B-1307, Oneida County records.


In 1984, Barker/Consolidated Papers indicates a "1/2 inch rod" in road per legend at this corner on his Section Subdivision Plat of Survey B-492, Oneida County records; I did find a standard 2" dia. aluminum monument with stamped Oneida County cap by Barker, which he set 33.00' West of the corner in 1994 as a reference monument, which I used for new ties indicated below.

In 1992, Schmit/Timberland Surveyors indicates that he found a 1" iron pipe at this corner per his Plat of Survey B-2874, Oneida County records; which I did not detect with locator.

Unfortunately, none of the foregoing surveys of record indicate any measured ties to BTs or other references. All original survey evidence by Jenkins/GLO in 1862 is obliterated.

This recovery completed June 23, 1998; there were no witnesses other than vehicle drive-bys.


Plan view map of monument location with bearing and distance ties to a minimum of four(4) described witness or reference monuments of concrete, natural stone, iron, live bearing trees or equivalent material. If applicable, also show a minimum of two(2) bearing and distance ties to any other monument found and not accepted; including the bearing and distance from the accepted monument. Indicate the basis for bearings of reference ties if not referenced to magnetic north.

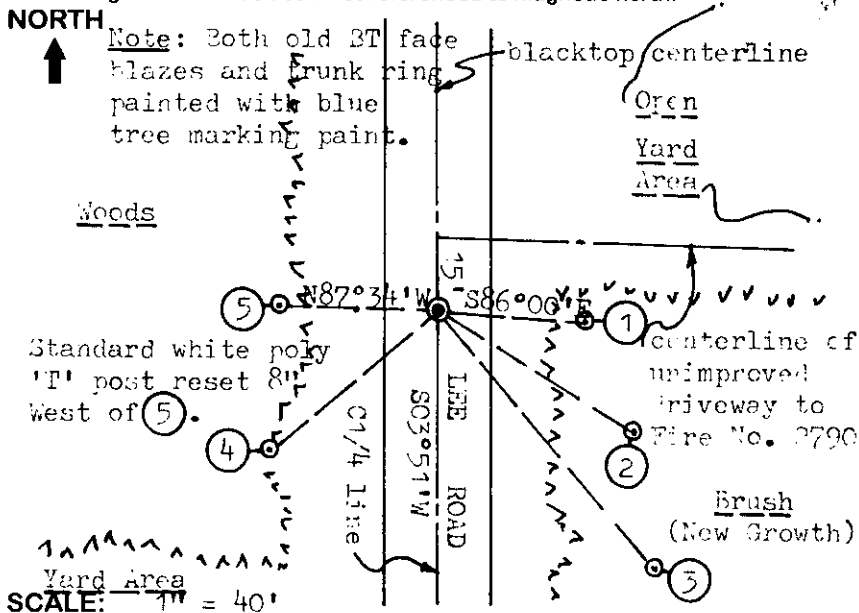

WITNESS MONUMENT TIES:

- ① 3/4" dia. iron pipe found with top 20" above grade, painted blue, S86°E 30.59'.
- ② Old BT 14" Pr S58°E 48.37' with 60d spike in left face, upper & lower blazes open & scribed.
- ③ Old BT 14" Pr S40°E 70.30' with 60d spike in right face root crown, upper & lower blazes open & scribed.
- ④ New BT 11" Pr S51°W 46.00'.
- ⑤ Standard 2" dia. aluminum pipe monument found with Oneida Co. cap stamped by Barker/RLS 1682 N87°34'W 33.00'.

Unless otherwise indicated, all bearing tree ties are to a .25" dia. by 2.5" long PK nail with a 1.25" dia. steel washer driven into unblazed right face and a .25" dia. by 2.5" long PK nail with a 2" dia. steel washer stamped 'BT' is also driven into unblazed face of bearing tree at DBH; the basis for measured bearings is magnetic to nearest degree and all tie distances are horizontal measure to nearest 1/100th feet.

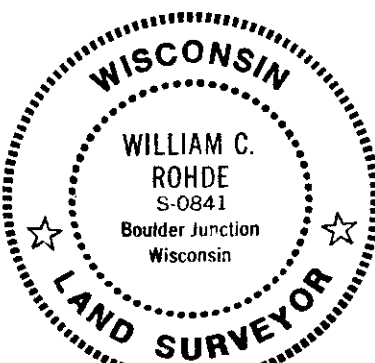

RLS SEAL

SHEET NO. 1 OF 1

LAND SURVEYOR CERTIFICATION:

I, William C. Rohde, hereby certify that I am a duly licensed Professional Land Surveyor in Wisconsin, that this USPLS monument location was determined by me or under my direction and control, and that this U.S. Public Land Survey Monument Location Record is true and correct to the best of my knowledge and belief.

William C. Rohde Date: 6-25-98
Signature

This form is intended to fulfill requirements of Chapter A-E 7.08 (3)(a)(b)(c)(d)(e)(f)(g)(h)(i) U.S. Public Land Survey Monument Location Record, Wisconsin Administrative Code. Use reverse side for geodetic location data and/or continuation purposes.

	20		

SECTION LOCATION MAP

INDEX NO. N 7

3606 170020

INDEX NO.