

CERTIFIED LAND CORNER RESTORATION

Index No. N-16

State of Wisconsin

County of Oneida } ss.



History of original corner establishment:
Old squared post bears S31W 53.0' of new position.

I Glen Barker, do hereby certify that on the 27th day of March, 19 84, I ~~renewed~~ re-established the W 1/16 corner of Section 17 & 20 Township 36, North, Range 6 East, Fourth Principal Meridian, as described hereon; and that from this evidence I established a new monument and accessories as described hereon to perpetuate the original location of this corner.

Resident witnesses:

J. Clafin - RLS

H. Wagoner

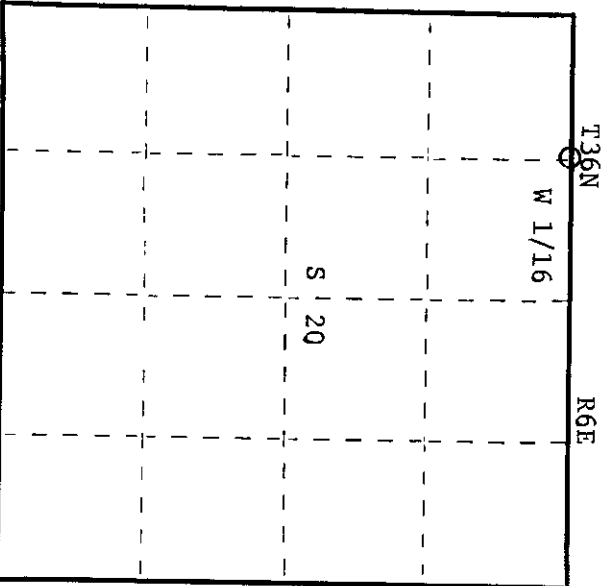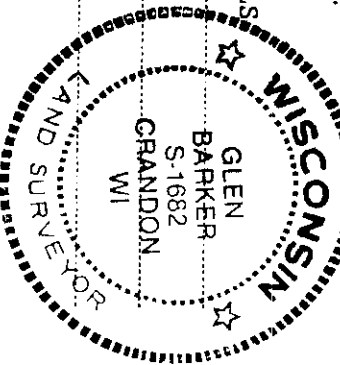

O = Corner monument restored.

CERTIFIED LAND CORNER RESTORATION

History of original corner establishment:

Old squared post bears S31W 53.0' of new position.

Description of corner evidence found:

Total distance from section corner 17-18-19-20 to 1/4 corner between sections 17 and 20 is 2698.50'.
Set W 1/16 1349.25' intermediate.

Description of monument and accessories I established to perpetuate the original location of this corner.
Set a 1" iron pipe with 2" diameter alloy cap stamped:
Monument projects 18" above ground

- Marked NBTs
- Jack pine 6" N29W 67.45' S 17
- Tamarack 6" S53W 40.08' W 1/16 S 20
- Scribed 1/16 B.T. T36N R6E
- CPI - 1984

Dated at Rhineclander, Wis., this 17th day of May, 1984.

Signature Glen Barker Title Registered Land Surveyor Registration No. 1682
(County Surveyor, Registered Land Surveyor, or other duly authorized official)

Office of Register of Deeds, County of Oneida I hereby certify that the within instrument was filed in this office for record on the 23rd day of May, 1984 at 11:08 o'clock A. M.

Terri Savage Tucker
(Register of Deeds)

By: _____ Deputy

3606170030