

State of Wisconsin }
County of Oneida } ss.

CERTIFIED LAND CORNER RESTORATION



Index No. L-6

History of original corner establishment:
No evidence of any previous corner.

I Glen Barker, do hereby certify that on the 21st day of March, 1984, I found ~~and established~~ the corner of Section 17, Township 36 North, Range 6 East, Fourth Principal Meridian, as described hereon; and that from this evidence I established a new monument and accessories as described hereon to perpetuate the original location of this corner.

Resident witnesses:

J. Claffin, Reg. Surveor
H. Wagoner

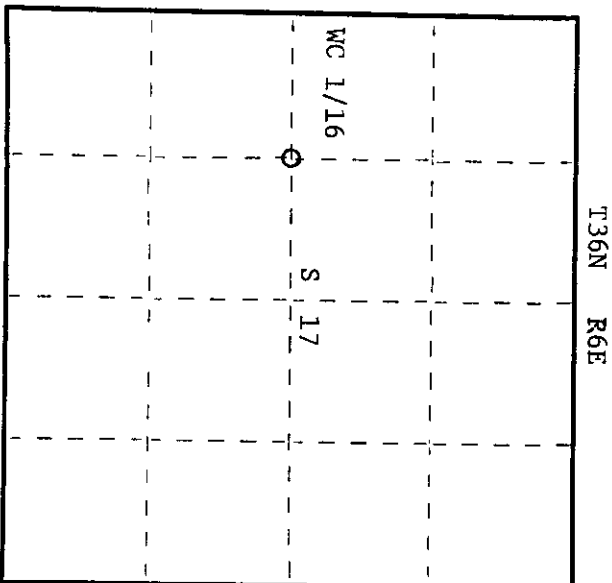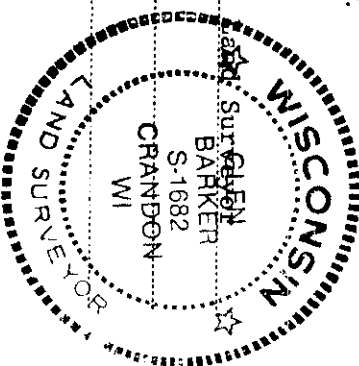

○ = Corner monument restored.

Description of monument and accessories I established to perpetuate the original location of this corner.

Description of corner evidence found:
Total distance from 1/4 corner between sections 17 and 18 to C 1/4 corner section 17 is 2640.31'.
Set WC 1/16 1320.16' intermediate.

Description of monument and accessories I established to perpetuate the original location of this corner.
Set a 1" iron pipe with 2" diameter alloy cap, stamped:
Monument projects 18" above ground.
Marked NBTs:

Jack Pine 7" S89W 9.36' S1682
Red Oak 7" N13W 31.28' T36N R6E
scribed 1/16 - B.T. WC 1/16 S 17
CPI - 1984

Dated at Rhinelander, Wis., this 19th day of April, 1984

Signature: *Glen Barker* Title: Registered Land Surveyor Registration No. 1682
(County Surveyor, Registered Land Surveyor, or other duly authorized official)

Office of Register of Deeds, County of Oneida
Instrument was filed in this office for record on the 23rd day of May, 1984
at 11:08 o'clock a.m. I hereby certify that the within

Doris George Kuehn
(Register of Deeds)

By: Deputy

3606172030