

CERTIFIED LAND CORNER RESTORATION

Index No. K-6

State of Wisconsin }  
County of Oneida } ss.


History of original corner establishment:  
No evidence of any previous corner.

I, Glen Barker, do hereby certify that on the 20th day of March, 1984, I ~~marked~~ established the NW 1/16 corner of Section 17

Township 36 North, Range 6 East, Fourth Principal Meridian, as described hereon; and that from this evidence I established a new monument and accessories as described hereon to perpetuate the original location of this corner.

Resident witnesses:


J. Clafin, Reg. and H. Wagoner

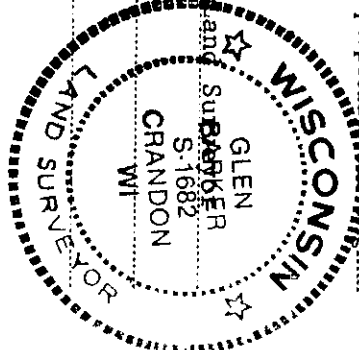

Description of corner evidence found:  
Corner established by subdivision of the NW 1/4 section 17. NW 1/16 sets 1294.94' of NC 1/16 and 1305.71' of WC 1/16.

Description of monument and accessories I established to perpetuate the original location of this corner.

Set a 1" iron pipe with 2" diameter alloy cap, stamped:  
Monument projects 18" above ground.  
Marked NBT's:  
Jack Pine 6" S54E 6.32' S1682  
Jack Pine 6" N65E 7.51' T36N R6E  
scribed 1/16 - B.T. NW 1/16 S 17  
CPI - 1984

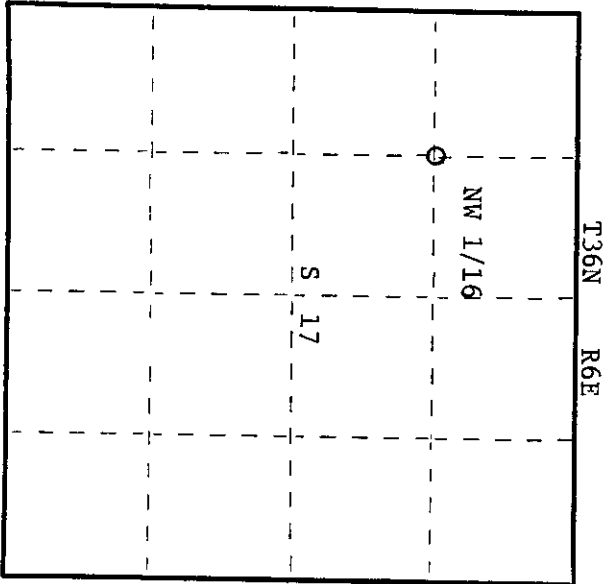

○ = Corner monument restored.

Dated at Rhinelander, Wis., this 19th day of April, 1984

Signature: Glen Barker Title: Registered Land Surveyor Registration No. 1682  
(County Surveyor, Registered Land Surveyor, or other duly authorized official)

Office of Register of Deeds, County of Oneida  
at 11:00 o'clock April 23rd day of May 1984  
Doris Leverage Fuchs I hereby certify that the within  
(Register of Deeds)

By: \_\_\_\_\_ Deputy

3606173030