

CERTIFIED LAND CORNER RESTORATION

Index No. 11-2

State of Wisconsin

County of Oneida } ss.

History of original corner establishment:  
No evidence of any previous corner.

I Glen Barker do hereby certify that on the 26th day of January, 1984, I ~~restored~~ established the ~~W 1/16~~ corner of Section 18 Township 36 North, Range 6 East, Fourth Principal Meridian, as described hereon; and that from this evidence I established a new monument and accessories as described hereon to perpetuate the original location of this corner.


Description of corner evidence found:

Total distance from section corner 13-24/18-19 T36N R5&6E to 1/4 corner between sections 18 & 19 is 2328.54'.  
Set W 1/16 on a proportionate measurement.  
W 1/16 sets 997.95' of section corner and 1330.59' of 1/4 corner.

Resident witnesses:


Jim Claflin - RLS

Herb. Wagoner

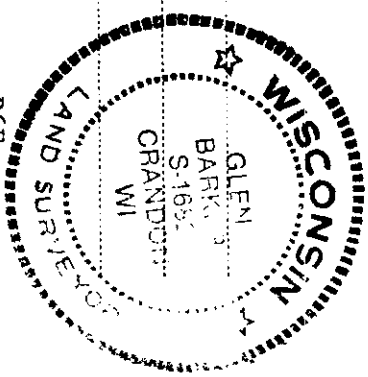

Description of monument and accessories I established to perpetuate the original location of this corner.

Set a 1" iron pipe with 2" diameter alloy cap stamped:  
Monument projects 18" above ground. S1682  
Marked NBTs T36N R6E  
Red pine 8" S61W 35.33' W 1/16 S 18  
Red pine 8" S50E 26.10' S 19  
Scribed 1/16 - B.T. CPI - 1984

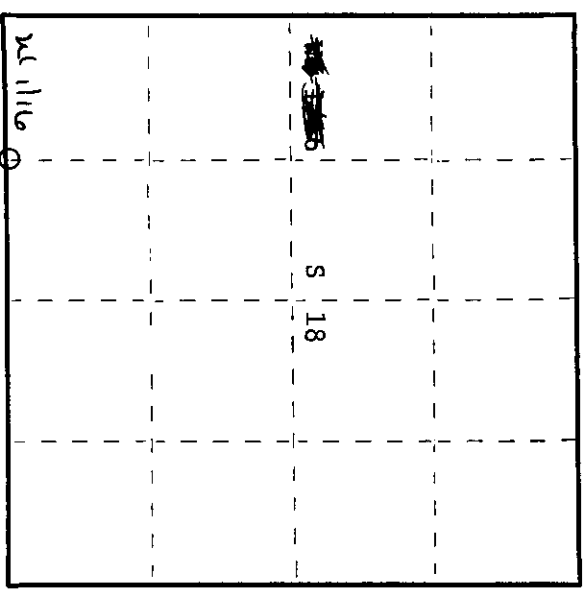

○ = Corner monument restored.

Dated at Rhinelander, Wis., this 20th day of February, 1984.

Signature: *Glen Barker* Title: Registered Land Surveyor Registration No. S1682  
(County Surveyor, Registered Land Surveyor, or other duly authorized official)

Office of Register of Deeds, County of Oneida  
Instrument was filed in this office for record on the 23rd day of May, 1984 at 11:08 o'clock A.M.

*Donna Savage Kuehn*  
(Register of Deeds)

By: \_\_\_\_\_ Deputy

3606 180030