

CERTIFIED LAND CORNER RESTORATION

Index No. 11-5

State of Wisconsin


County of Oneida } ss.

History of original corner establishment:
3/4" iron pipe and a squared cedar post S30E 3.15' of new monument.

I Glen Barker, do hereby certify that on the 12th day of March, 1984, I ~~found~~ re-established the S 1/16 corner of Sections 17 & 18 Township 36, North, Range 6 East, Fourth Principal Meridian, as described hereon; and that from this evidence I established a new monument and accessories as described hereon to perpetuate the original location of this corner.

Resident witnesses:


J. Clafflin, Reg. Land Surveyor
H. Wagoner

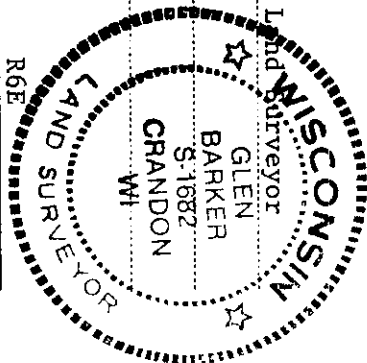

Description of monument and accessories I established to perpetuate the original location of this corner.

Set a 1" iron pipe with 2" diameter alloy cap stamped:
Monument projects 12" above ground.

Marked NBTs:
Maple 6" S6°E 20.55' S1682
Maple 6" S34W 44.56' T36N R6E
scribed 1/16 B.T. S 1/16 18 17
CPI - 1984

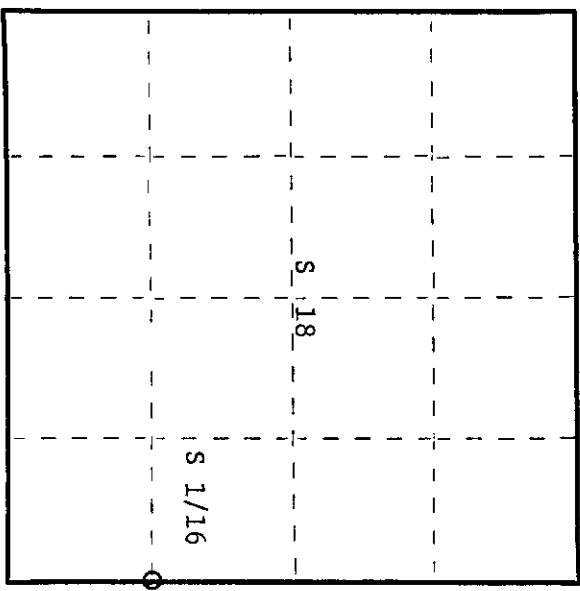

Description of corner evidence found:

Total distance from section corner 17-18-19-20 to 1/4 corner between sections 17 and 18 is 2686.62'.
Set S 1/16 1343.31 intermediate.

Dated at Rhineland, Wis., this 19th day of April, 1984.

Signature Glen Barker Title Registered Land Surveyor Registration No. 1682
(County Surveyor, Registered Land Surveyor, or other duly authorized official)
Office of Register of Deeds, County of Oneida, I hereby certify that the within instrument was filed in this office for record on the 23rd day of May, 1984 at 11:00 o'clock A. M.

Dorothy Tenaga Kuehn
(Register of Deeds)

By Dorothy Tenaga Kuehn Deputy

3606181000