

CERTIFIED LAND CORNER RESTORATION

Index No. 11-3

State of Wisconsin } ss.
 County of Oneida

History of original corner establishment:
 No evidence of any previous corner.


I Glen Barker, do hereby certify that on the 26th day of January, 19 84, I ~~found~~ found the SC 1/16 corner of Section 18, Township 36N, North, Range 6 East, Fourth Principal Meridian, as described hereon; and that from this evidence I established a new monument and accessories as described hereon to perpetuate the original location of this corner.

Description of corner evidence found:
 Total distance from 1/4 corner between sections 18 & 19 to C 1/4 section 18 is 2657.23'.
 Set SC 1/16 1328.62' Intermediate.

Resident witnesses:

Jim Claflin - RLS


Herb. Wagoner

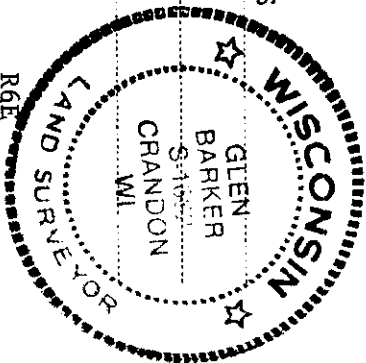

T36N

R6E

Description of monument and accessories I established to perpetuate the original location of this corner.
 Set a 1" iron pipe with 2" diameter alloy cap stamped:
 Monument projects 12" above ground. S1682
 T36N R6E
 Marked NBTs SC 1/16 S 18
 Jack pine 7" S82E 10.47'
 Jack pine 6" S26W 33.58'
 Scribed 1/16 - B.T. CPI - 1984

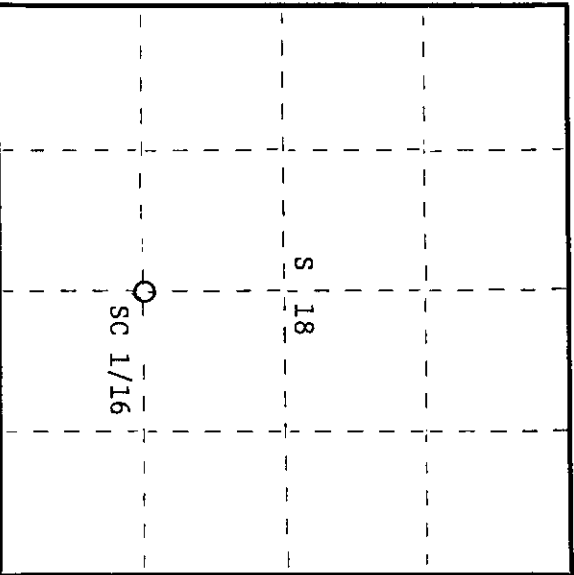

○ = Corner monument restored.

Dated at Rhineland, Wis., this 20th day of February, 19 84.

Signature [Signature] Title Registered Land Surveyor Registration No. S1682
 (County Surveyor, Registered Land Surveyor, or other duly authorized official)

Office of Register of Deeds, County of Oneida, I hereby certify that the within instrument was filed in this office for record on the 23rd day of May, 19 84 at 11:00 o'clock A. M.

[Signature]
 (Register of Deeds)

By [Signature] Deputy

3606181020