

CERTIFIED LAND CORNER RESTORATION

Index No. R-4


History of original corner establishment:  
Someones 2" iron pipe sets on right of way edge of Prairie Rapids Road N10E 20.57' of new position.

State of Wisconsin

County of Oneida } ss.


I Glen Barker, do hereby certify that on the 14th day of December, 1983, I found the ~~original~~ <sup>restoration</sup> of the corner of Sections 19 & 30 Township 36 North, Range 6 East, Fourth Principal Meridian, as described hereon; and that from this evidence I established a new monument and accessories as described hereon to perpetuate the original location of this corner.

Resident witnesses:  
J. Clafin - RLS  
H. Wagoner

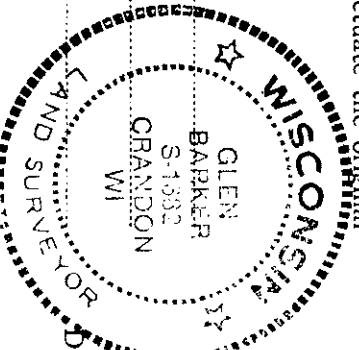

Description of corner evidence found:  
Total distance from section corner 19-20-29-30 to 1/4 corner between sections 19 & 30 is 2617.08 ft.  
Set E 1/16 1308.54 Intermediate.

Description of monument and accessories I established to perpetuate the original location of this corner.  
Set a railroad spike in center line of Prairie Rapids Road for true corner.  
Set a 1" iron pipe with 2" diameter alloy cap 33 ft. south of true corner for reference monument. Cap stamped:  
Marked NBT to true corner  
Red pine 22" S49E 52.67' E 1/16 S 19 REF. Cor.  
B.O. 2" iron pipe N10E 20.57' N. 33 Ft.  
S1682 - 1983

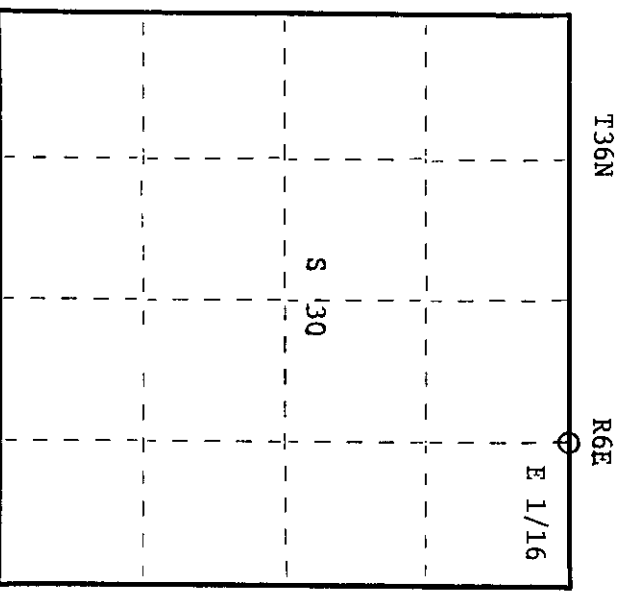

○ = Corner monument restored.

Dated at Rhinelander, Wis., this 13th day of February, 1984

Signature Glen Barker Title Registered Land Surveyor Registration No. S1682  
(County Surveyor, Registered Land Surveyor, or other duly authorized official)

Office of Register of Deeds, County of Oneida  
Instrument was filed in this office for record on the 23rd day of May, 1984 at 1:00 o'clock P.M.

Tonia Lange Tushnet  
(Register of Deeds)

By \_\_\_\_\_ Deputy

3606190010