
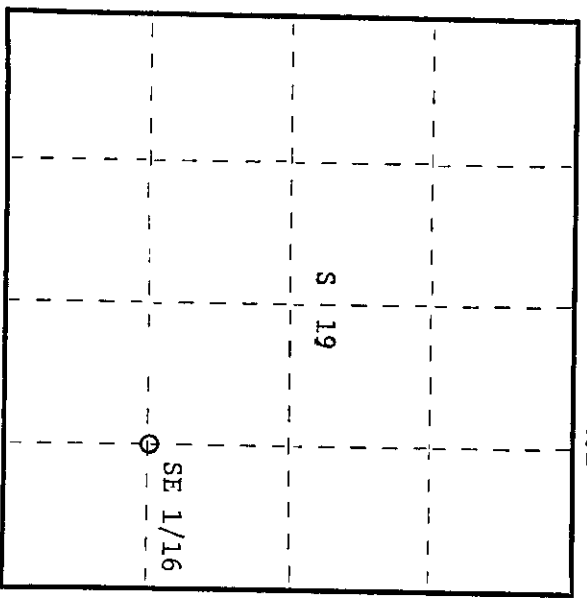


State of Wisconsin }  
County of Oneida } ss.

I Glen Barker, do hereby certify that on the 2nd day of March 1984, I found ~~established~~ ~~the~~ SE 1/16 corner of Section 19 Township 35 North, Range 6 East, Fourth Principal Meridian, as described hereon; and that from this evidence I established a new monument and accessories as described hereon to perpetuate the original location of this corner.

Resident witnesses:  
J. Clafin - RLS  
H. Wagoner

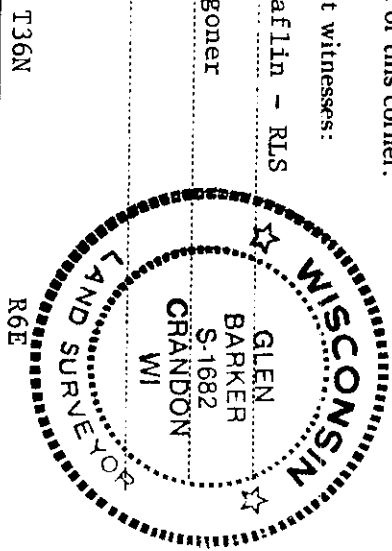

○ = Corner monument restored.

CERTIFIED LAND CORNER RESTORATION

Index No. 3-4

History of original corner establishment:  
No evidence of any previous corner.

Description of corner evidence found:

Corner established by subdivision of the SE 1/4 Section 19. SE 1/16 set 1311.83' of SC 1/16 and 1309.67' of EC 1/16.

Description of monument and accessories I established to perpetuate the original location of this corner.

- Set a 1" iron pipe with 2" diameter alloy cap stamped: S1682
- Monument projects 18" above ground T36N R6E
- Marked NBTs
- Jack pine 6" N70W 14.21' SE 1/16 S 19
- Jack pine 4" N45E 27.53'
- Scribed 1/16 - B.T. CPI - 1984

Dated at Rhinelander, Wis., this 19th day of April, 1984

Signature: *Glen Barker* Title: Registered Land Surveyor Registration No. 1682  
(County Surveyor, Registered Land Surveyor, or other duly authorized official)  
Office of Register of Deeds, County of Oneida  
Instrument was filed in this office for record on the 23rd day of May, 1984 at 11:00 o'clock A.M.

*Dawn Lange Kuelan*  
(Register of Deeds)

By: Deputy