

CERTIFIED LAND CORNER RESTORATION

Index No. P-3


State of Wisconsin } ss.
 County of Oneida

History of original corner establishment:
 Old fence corner & 1 1/2" iron pipe

I Glen Barker do hereby
 certify that on the 13th day
 of February 19 84, I ~~renewed~~ Estab.
~~renewed~~ the C 1/4

corner of Section 19
 Township 36 North, Range
 6 East, Fourth Principal Meridian,
 as described hereon; and that from this evidence
 I established a new monument and accessories
 as described hereon to perpetuate the original
 location of this corner.

Resident witnesses:
 J. Clafin -
 H. Wagoner

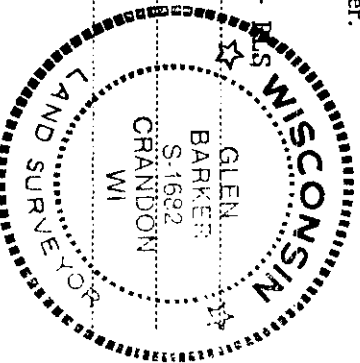


Description of corner evidence found:

Established C 1/4 corner Section 29 at intersection of North-South and East-West
 quarter lines.
 Corner sets 2643.70' of N 1/4 corner, 2544.42' of W 1/4 corner
 2630.31' of E 1/4 corner
 2630.69' of S 1/4 corner
 New established corner bears N89-09-18E 3.39' of old fence and 1 1/2" iron pipe.

Description of monument and accessories I established to perpetuate the original location of this corner.

Set a 2 1/2" aluminum pipe with alloy cap stamped:

Monument projects 18" above ground	T36N	R6E
Marked NBTs	C 1/4	S 19
Jack pine 6"	N71E	20.78'
Jack pine 7"	N79E	18.45'
Jack pine 7"	N58W	3.71'
Scribed C 1/4 B.T.		S1682 - 1984

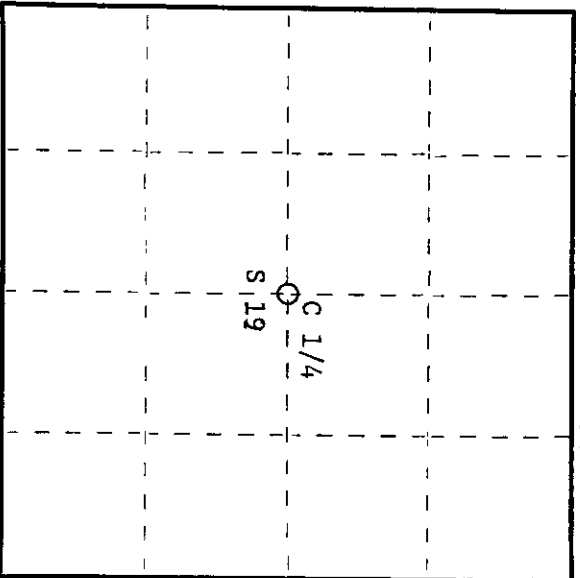

○ = Corner monument restored.

Dated at Rhinelander Wis., this 22nd day of March 1982

Signature *Glen Barker* Title Registered Land Surveyor Registration No. S1682
 (County Surveyor, Registered Land Surveyor, or other duly authorized official)

Office of Register of Deeds, County of Oneida
 Instrument was filed in this office for record on the 23rd day of May 1984
 at 11:00 o'clock A.M.

James George Tomlin
 (Register of Deeds)

By Deputy