

CERTIFIED LAND CORNER RESTORATION



Index No. 0-4

State of Wisconsin } ss.
County of Oneida }

History of original corner establishment:
No evidence of any previous corner.

I Glen Barker do hereby
certify that on the 23rd day
of February, 1984, I and Estab.
~~was~~ of the NE 1/16
corner of Section 19
Township 35
6 East, North, Range
Fourth Principal Meridian,
as described hereon; and that from this evidence
I established a new monument and accessories
as described hereon to perpetuate the original
location of this corner.

Resident witnesses:
J. Clafflin - R
H. Wagoner

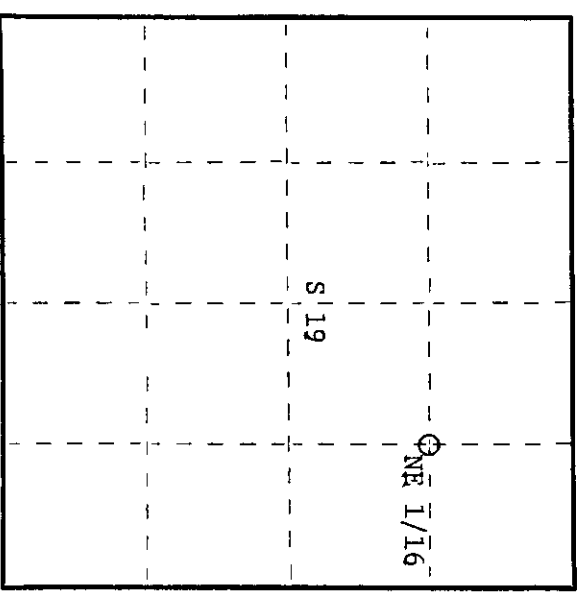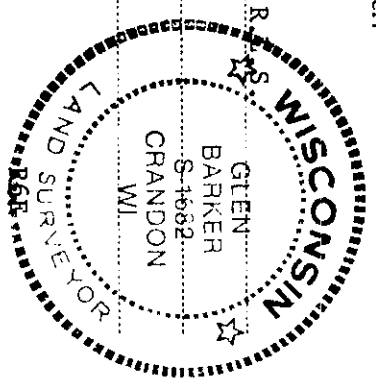

○ = Corner monument restored.

Description of corner evidence found:
Corner established by subdivision of the NE 1/4
NE 1/16 sets 1318.45' of NC 1/16 and 1318.39' of EC 1/16

Description of monument and accessories I established to perpetuate the original location of this corner.
Set a 1" iron pipe with 2" diameter alloy cap stamped S1682
Monument projects 18" above ground T36N R6E
Marked NBTs NE 1/16 S 19
Jack pine 7" N63W 6.11'
White pine 16" N39E 51.06'
Scribed 1/16 - B.T. CPI - 1984

Dated at Rhinelander, Wis., this 22nd day of March, 1984

Signature: *Glen Barker* Title: Registered Land Surveyor Registration No. S1682
(County Surveyor, Registered Land Surveyor, or other duly authorized official)
Office of Register of Deeds, County of Oneida
Instrument was filed in this office for record on the 23rd day of February, 1984
at 10 o'clock A.M. I hereby certify that the within

Louis George Kunkin
(Register of Deeds)

By: Deputy

3606193010