

CERTIFIED LAND CORNER RESTORATION



Index No. E-6

State of Wisconsin }
 County of Oneida } ss.

I, Glen Barker, do hereby certify that on the 24th day of February, 19 84, I ~~found~~ established the W 1/16 corner of Section 29 Township 36, North, Range 6 East, Fourth Principal Meridian, as described hereon; and that from this evidence I established a new monument and accessories as described hereon to perpetuate the original location of this corner.

Resident witnesses:

J. Clafflin, Reg. Land Surveyor
H. Wagoner

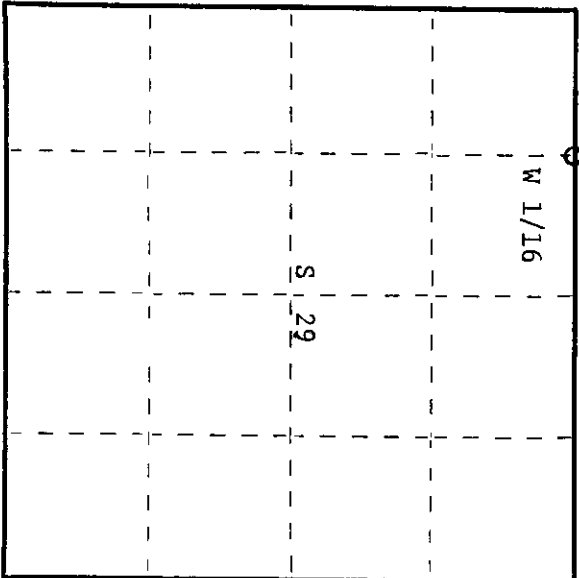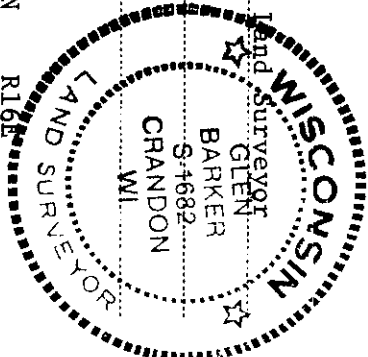

○ = Corner monument restored.

History of original corner establishment:

No evidence of any previous corner.

Description of corner evidence found:

Total distance from section corner 19-20-29-30 to 1/4 corner between sections 20 and 29 is 2673.37'.
 Set W 1/16 1336.685' intermediate.

Description of monument and accessories I established to perpetuate the original location of this corner.

Set a railroad spike in center line of Prairie Rapids Road for true corner.
 Set a 1" iron pipe with 2" diameter alloy 33.0 north of true corner for reference corner. Cap stamped:
 Monument projects 18" above ground.
 Marked NBTs:
 Jack Pine 8" N43E 43.43' T36N R6E
 Jack Pine 6" N40W 50.39' W 1/16 S 20 Ref.
 scribed 1/16-B.T. 25' S 33 Ft. S 120 Ref.
 CPT - 1984

Dated at Rhineland, Wis., this 19th day of April, 19 84

Signature: _____ Title: Registered Land Surveyor Registration No. 1682
 (County Surveyor, Registered Land Surveyor, or other duly authorized official)

Office of Register of Deeds, County of Oneida, I hereby certify that the within instrument was filed in this office for record on the 23rd day of May, 19 84 at 11:08 o'clock A.M.

Doris Tenaga Fuchs
 (Register of Deeds)

By: _____ Deputy