

CERTIFIED LAND CORNER RESTORATION

Index No. Q-6


State of Wisconsin }
County of Oneida } ss.

History of original corner establishment:
No evidence of any previous corner


I Glen Barker, do hereby certify that on the 17th day of April, 1984, I ~~restored~~ established the SW 1/16 corner of Section 20 Township 36, North, Range 6 East, Fourth Principal Meridian, as described hereon; and that from this evidence I established a new monument and accessories as described hereon to perpetuate the original location of this corner.

Resident witnesses:

J. Clafflin
H. Wagoner

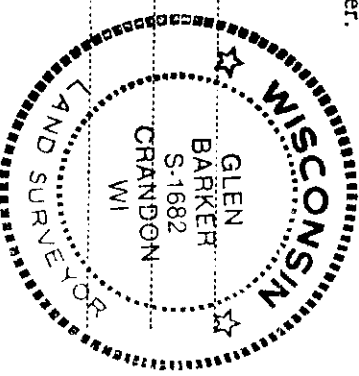

T36N R6E

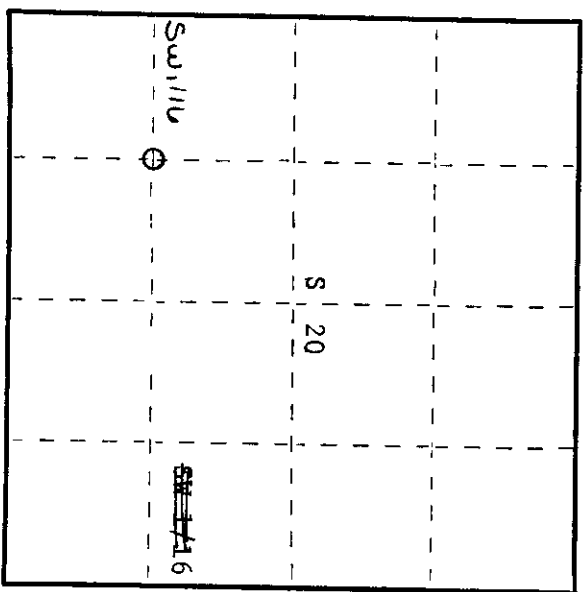

○ = Corner monument restored.

Description of corner evidence found:
Corner established by subdivision of the SW 1/4.
SW 1/16 sets 1339.93' of SC 1/16 and 1311.48' of WC 1/16.

Description of monument and accessories I established to perpetuate the original location of this corner.
Set a 1" iron pipe with a 2" diameter alloy cap stamped:
Monument projects 18" above ground.

Marked NPTs			
Red pine 8"	S23E	77.74'	SW 1/16 S 20
Red pine 10"	S78E	63.45'	
	1/16 - B.T.		CPI - 1984

Dated at Princeton, Wis., this 17th day of May, 1984.

Signature Glen Barker Title Registered Land Surveyor Registration No. 1682
(County Surveyor, Registered Land Surveyor, or other duly authorized official)

Office of Register of Deeds, County of Oneida
instrument was filed in this office for record on the 23rd day of May at 1:00 o'clock P.M. I hereby certify that the within

Doris George Tucker
(Register of Deeds)

By _____ Deputy