

CERTIFIED LAND CORNER RESTORATION

Index No. Q - 5

State of Wisconsin

County of Oneida } ss.

History of original corner establishment:
No evidence of any previous corner

I Glen Barker, do hereby
certify that on the 10th day
of February, 19 84, I ~~found~~ found Estab.
~~xxxxxxx~~ the S 1/16
corner of Sections 19 & 20
Township 36, North, Range
6 East, Fourth Principal Meridian,



as described hereon; and that from this evidence
I established a new monument and accessories
as described hereon to perpetuate the original
location of this corner.

Resident witnesses:

J. Claflin - RLS

H. Wagoner

T36N

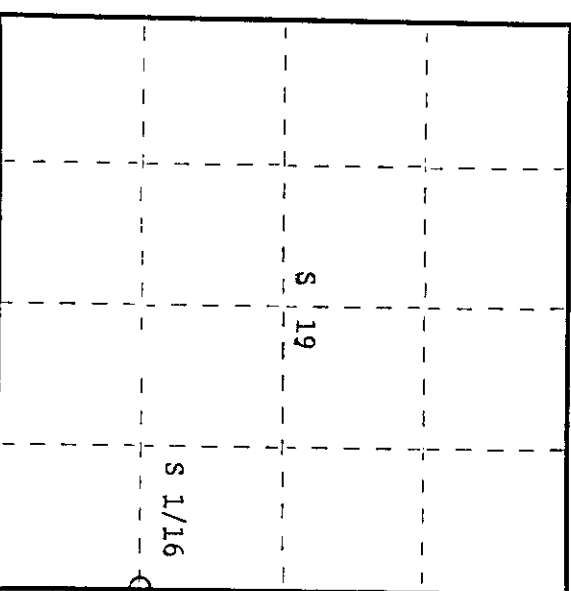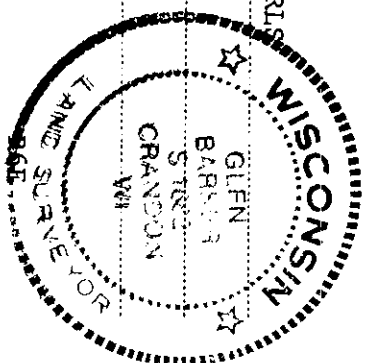

○ = Corner monument restored.

Description of corner evidence found:
Total distance from section corner 19-20-29-30 to 1/4 corner between sections 19 & 20 is 2608.02'.
Set S 1/16 1304.01 intermediate

Description of monument and accessories I established to perpetuate the original location of this corner.
Set a 1" iron pipe with 2" diameter alloy cap stamped:
Monument projects 18" above ground
Marked NBTs
Cedar 7" N80W 26.91' S 1/16 19 20
Cedar 8" S64W 36.42' T36N R6E
Scribed 1/16 - B.T. CPI - 1984

Dated at Rhinelander, Wis., this 22nd day of March, 19 84.

Signature Glen Barker Title Registered Land Surveyor Registration No. S1682
(County Surveyor, Registered Land Surveyor, or other duly authorized official)

Office of Register of Deeds, County of Oneida
Instrument was filed in this office for record on the 23rd day of May, 19 84
at 11:08 o'clock A.M. I hereby certify that the within

Tonia George Kuehn
(Register of Deeds)

By: _____ Deputy