

CERTIFIED LAND CORNER RESTORATION

Index No. P-7


State of Wisconsin }
County of Oneida } ss.

History of original corner establishment:
No evidence of any previous corner.

I Glen Barker, do hereby certify that on the 16th day of April, 19 84, I found ~~established~~ established corner of Section 20, Township 36, North, Range 6 East, Fourth Principal Meridian, as described hereon; and that from this evidence I established a new monument and accessories as described hereon to perpetuate the original location of this corner.

Resident witnesses:

J. Claflin CRANDON
H. Wagoner WI

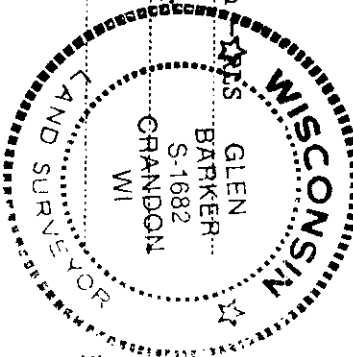

Description of corner evidence found:


- Corner established by subdivision of Section 20.
- C 1/4 sets 2643.68' of N 1/4 corner
- 2599.44' of E 1/4 corner
- 2637.88' of S 1/4 corner
- 2686.39' of W 1/4 corner

Description of monument and accessories I established to perpetuate the original location of this corner.

Set a rail road spike in center line of Lee Road for true corner.

Set a 2 1/2" aluminum pipe with alloy cap east 34.0' for reference corner, cap stamped:

Marked NRTs to true corner			
Jack pine 5"	S43W	57.25'	T36N R6E
Jack pine 5"	S69W	82.82'	
Jack pine 8"	N64W	41.26'	
	C 1/4 B.T.		
		W. 34 Ft.	
		S1682-1984	

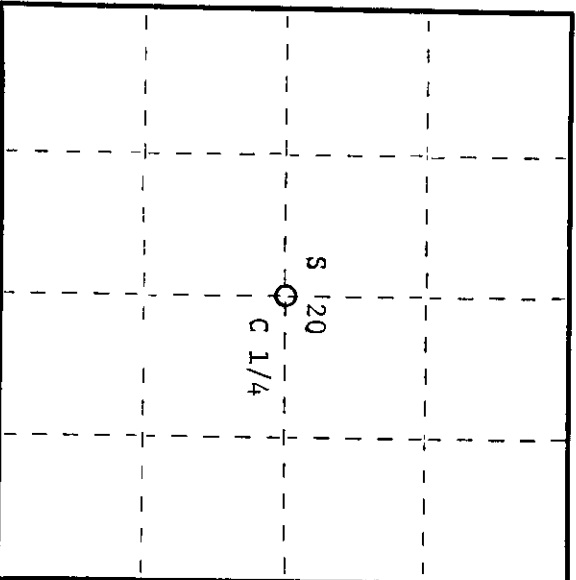

O = Corner monument restored.

Dated at Rhinelander, Wis., this 17th day of May, 19 84

Signature Glen Barker Title Registered Land Surveyor Registration No. 1682
(County Surveyor, Registered Land Surveyor, or other duly authorized official)

Office of Register of Deeds, County of Oneida, I hereby certify that the within instrument was filed in this office for record on the 23rd day of May, 19 84 at 1:00 o'clock a. M.

Doris Savage Kuehn
(Register of Deeds)

By Doris Savage Kuehn Deputy