

CERTIFIED LAND CORNER RESTORATION

Index No. P-6



State of Wisconsin

County of Oneida } ss.

I Glen Barker, do hereby certify that on the 27th day of March, 1984, I found ~~Established~~ the WC 1/16 corner of Section 20 Township 36 North, Range 6 East, Fourth Principal Meridian, as described hereon; and that from this evidence I established a new monument and accessories as described hereon to perpetuate the original location of this corner.

History of original corner establishment:
No evidence of any previous corner.

Resident witnesses:
Jim Clafin - R6E
H. Wagoner

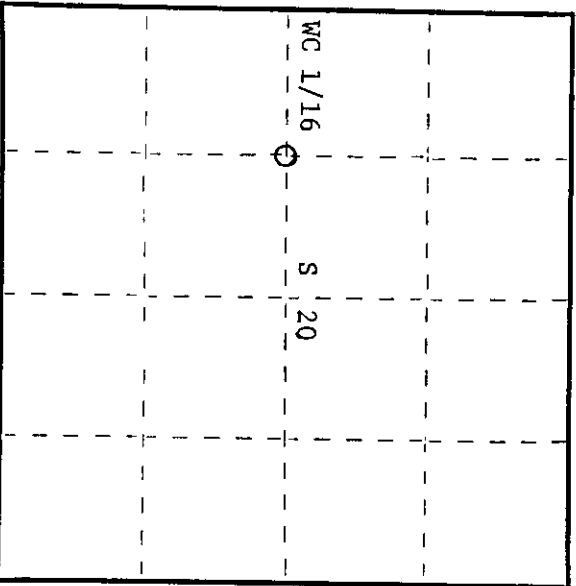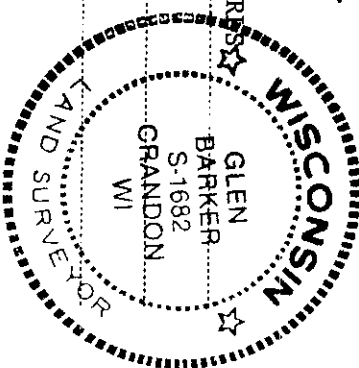

○ = Corner monument restored.

Description of corner evidence found:
Total distance from 1/4 corner between Sections 17 and 20 to C 1/4 Section 20 is 2686.39'.
Set WC 1/16 1343.19 intermediate.

Description of monument and accessories I established to perpetuate the original location of this corner.
Set a 1" iron pipe with 2" diameter alloy cap stamped:
Monument projects 18" above ground. S1682
Marked NBTs T36N R6E
White birch 10" S28W 54.78' WC 1/16 S 20
Jack pine 8" N27E 28.81' CPI - 1984
1/16 - B.T.

Dated at Rhineland, Wis., this 17th day of May, 1984.

Signature: Glen Barker Title: Registered Land Surveyor Registration No. 1682
(County Surveyor, Registered Land Surveyor, or other duly authorized official)

Office of Register of Deeds, County of Oneida
Instrument was filed in this office for record on the 23rd day of May, 1984. I hereby certify that the within instrument was filed at 11:00 o'clock A.M.

By: Doris Verage Tucker
(Register of Deeds)

By: _____ Deputy