

CERTIFIED LAND CORNER RESTORATION

Index No. 0-8

State of Wisconsin }  
County of Oneida } ss.


History of original corner establishment:  
No evidence of any previous corner.

I, Glen Barker, do hereby certify that on the 5th day of April, 1984, I found ~~Restored~~ the NE 1/16 corner of Section 20, Township 36 North, Range 6 East, Fourth Principal Meridian, as described hereon; and that from this evidence I established a new monument and accessories as described hereon to perpetuate the original location of this corner.


Description of corner evidence found:  
Corner established by subdivision of the NE 1/4. NE 1/16 sets 1322.25' of NC 1/16 and 1323.54' of EC 1/16.

Resident witnesses:

J. Clafin  
H. Wagoner

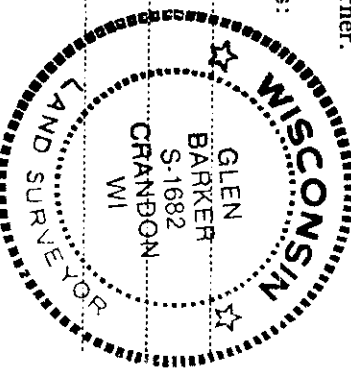

T36N R6E

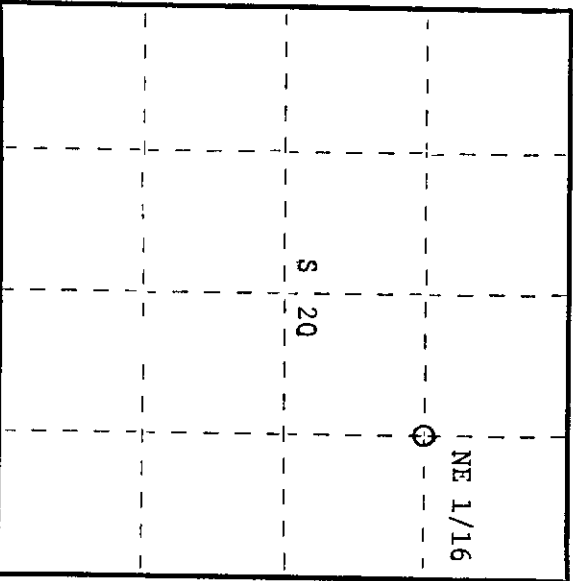

○ = Corner monument restored.

Description of monument and accessories I established to perpetuate the original location of this corner.

Set a 1" iron pipe with 2" diameter alloy cap stamped:

S1682  
T36N R6E

Monument projects 18" above ground.

NE 1/16 S 20

Marked NBTs

Red pine 8" S38W 10.22'  
Red pine 10" S31E 9.16'  
1/16 - B.T. CPI - 1984

Dated at Rhinelander, Wis., this 17th day of May, 1984.

Signature: *Glen Barker* Title Registered Land Surveyor Registration No. 1682  
(County Surveyor, Registered Land Surveyor, or other duly authorized official)

Office of Register of Deeds, County of Oneida  
Instrument was filed in this office for record on the 23rd day of May, 1984 at 11:08 o'clock A.M. I hereby certify that the within

*Doris Verage Kuehn*  
(Register of Deeds)

By: Deputy

3606203010